

SURVEY & REMONUMENTATION

FEB 11 1998

Liber 00002 Page 0434

SECTION

LAND CORNER RECORDATION CERTIFICATE
Filing Requirement of Act 74, Mich. P.A. 1970

ANTRIM COUNTY MI.
Register of Deeds
Recorded

12-22-1997 10:11:55

Manda R. Conway
REGISTER OF DEEDS

Register of Deeds Stamp & File Number

For corners in

CENTRAL LAKE

ANTBIM _____
(County)

Located In: Corner Code #

- | | | | |
|------------------------------------|----------|------------|-----|
| 1. Public Land Survey | S 1/4 | T.31N R.8W | L-9 |
| | SEC 24 | T. R. | |
| | | T. R. | |
| | | T. R. | |
| 2. Property Controlling in Section | S. T. R. | | |
| | S. T. R. | | |
| 3. Miscellaneous Property in Sec. | S. T. R. | | |
| | S. T. R. | | |

4. Lot No. _____, Recorded Plat _____

5. Private Claims _____

	A	B	C	D	E	F	G	H	I	J	K	L	M
1													
2	6		5		4			3		2		1	
3													
4	7		8		9			10		11		12	
5													
6	18		17		16			15		14		13	
7													
8	19		20		21			22		23		24	
9													
10	30		29		28			27		26		25	
11													
12	31		32		33			34		35		36	
13													

I, RICHARD J. KRAL, in a field survey on 8-21-97, 1997 do hereby state that under requirements of P.A. 74, Michigan P.A. of 1970, the corner points mentioned in lines 1 and 2 above were in conformance with regulations and rules therefore as required in the current manual of survey instructions of the United States Department of the Interior, Bureau of Land Management or by a decree of a Court of Law and for that the corner points mentioned in lines 3, 4 and 5 above were in conformance with the rules of the Michigan Board of Land Surveyors or by a Decree of a Court of Law; established, re-established, monumented, recovered, found as expressed below:

NOTE: Not more than 2 corners, all in the same town and range, may be recorded on this certificate.

A. Description of original monument and accessories and/or subsequent restoration:

- L-9, 1/4 CORNER COMMON TO SEC.'S 24 & 25, T31N-R8W
1857, SUBDIVISION OF TWP., RE-SURVEY BY E.D. ATWATER; SET POST 3" SUGAR POST, 12" SUGAR N6 1/2°W, 10 LKS (6.60'); 21" SUGAR S18°W, 12 LKS (7.92').
1912, SURVEY BK #1, PG. 330 BY F.S. CHURCH, CO. SURVEYOR; SET CORNER WITH 3/4" X 38" BOLT WITH SQUARE HEAD ON TOP, AT SINGLE PROPORTION METHOD.
1973, SURVEY BY R.C. DUNN, RECORDED IN LIB. 218, PG. 340; SHOWS CORNER, NO DESCRIPTION OR ACCESSORIES.
1976, SURVEY AND LCRC. BY N.B. DEYOUNG RECORDED IN LIB. 001, PG. 223, FD 1" SQUARE ROD ON FEN. E-W & CL OLD 2-TRACK N-S; 22" MAPLE S25°W, 47.3'; 30" MAPLE, N15°E, 68.25'; 30" MAPLE, S30°E, 86.5'
1977, SURVEY REC. IN LIB. 233, PG. 808; AND LCRC. REC. IN LIB. 001, PG. 238 BY A. LENNOX CO. SURVEYOR; FD BOLT; 36" MAPLE, N20°E, 68.05'; 30" MAPLE, S30°E, 86.54' 24" MAPLE, S30°W, 46.00'
1978, SURVEY BY N.B. DEYOUNG; FD 1" SQUARE ROD; 22" MAPLE, S25°W, 47.3'; 30" MAPLE, S30°E, 86.5'

B. Description of corner evidence found and/or method applied in restoring or reestablishing corner:

- L-9, 1/4 CORNER COMMON TO SEC.'S 24 & 25, T31N-R8W
FD. 1/2" X 3/4" IRON ROD 7' EAST OF E. N-S GR. ROAD
PULLED & REPLACED WITH ANTRIM COUNTY MONUMENT (BERNTSEN MODEL G-1 (30" PISTON) WITH G-2 CAP).
FD 36" MAPLE, N12°E, 69.28" (R 68.05', R 68.25')
FD 36" MAPLE, S10°E, 87.39" (R 86.54', R 86.5')
FD 24" MAPLE, S41°W, 47.90" (R 46.99', R 47.3')
NO G.L.O. WITNESS WERE FOUND.


C. Description of monument for corner and accessories established to perpetuate locating the position of the corner:

- L-9, 1/4 CORNER COMMON TO SEC.'S 24 & 25, T31N-R8W
FD. 1/2" X 3/4" IRON ROD 7' EAST OF E. N-S GR. ROAD
PULLED & REPLACED WITH ANTRIM COUNTY MONUMENT.
SET NAIL ON SIDE 36" MAPLE, N12°E, 69.28" (R 68.05', R 68.25')
SET NAIL ON SIDE 36" MAPLE, S10°E, 87.39" (R 86.54', R 86.5')
SET NAIL ON SIDE 24" MAPLE, S41°W, 47.90" (R 46.99', R 47.3')
SET NAIL ON SIDE POWER POLE, N84°W, 40.04'
SET NAIL ON SIDE POWER POLE, S45°E, 45.80'

Ratified by Peer
Group in accordance
with P.A. 345
Antrim Co. Chairman

Arthur L. Lennox

Arthur L. Lennox
Nov. 18, 1997

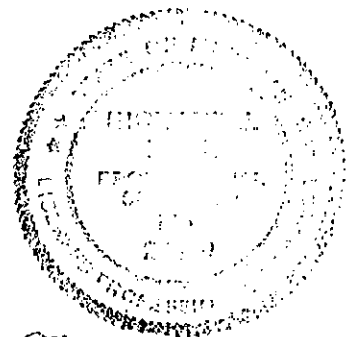

Signed by Richard J. Kral

Date 12-14-97

Surveyor's Michigan License No. 26460