

FEB 11 1998

Liber 00002 Page 0435

SECTION

LAND CORNER RECORDATION CERTIFICATE ANTRIM COUNTY MI.
Filing Requirement of Act 74, Mich. P.A. 1970

For corners in

CENTRAL LAKE

Register of Deeds
Recorded

12-22-1997 10:12:05

Wanda R. Conway
REGISTER OF DEEDS

Register of Deeds Stamp & File Number

Located In: _____ Corner Code # _____

ANTRIM _____ Located In: _____ Corner Code # _____
(County)

1. Public Land Survey E 1/4 T.31N R.8W M-6
SEC 13 T.31N R.7W A-6
T. _____ R. _____
T. _____ R. _____

2. Property Controlling S. _____ T. _____ R. _____
in Section S. _____ T. _____ R. _____

3. Miscellaneous S. _____ T. _____ R. _____
Property in Sec. S. _____ T. _____ R. _____

4. Lot No. _____, Recorded Plat _____

5. Private Claims _____

I, RICHARD J. KRAL, in a field survey 8-21-97, 1997
do hereby state that under requirements of P.A. 74, Michigan P.A. of 1970, the corner points
mentioned in lines 1 and 2 above were in conformance with regulations and rules therefore as
required in the current manual of survey instructions of the United States Department of the Interior,
Bureau of Land Management or by a decree of a Court of Law and /or that the corner points
mentioned in lines 3, 4 and 5 above were in conformance with the rules of the Michigan Board of
Land Surveyors or by a Decree of a Court of Law; established, re-established, monumented,
recovered, found as expressed below:

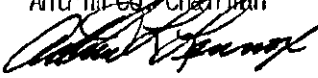
NOTE: Not more than 2 corners, all in the same town and range, may be recorded on this certificate.

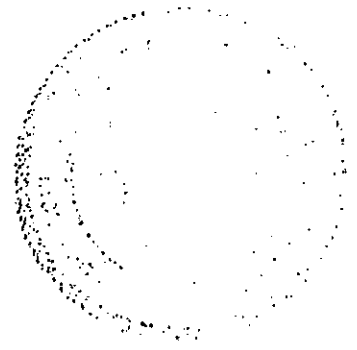
	A	B	C	D	E	F	G	H	I	J	K	L	M
1													
2	6		5		4		3		2		1		
3													
4	7		8		9		10		11		12		
5													
6	18		17		16		15		14		13		
7													
8	19		20		21		22		23		24		
9													
10	30		29		28		27		26		25		
11													
12	31		32		33		34		35		36		
13													

A. Description of original monument and accessories and/or subsequent restoration:
M-6, 1/4 CORNER COMMON TO SEC. 13, T31N-R8W & A-6, SEC. 18, T31N-R7W
 1856, RESURVEY TWP. BOUNDARY BY E.D. ATWATER; SET CORNER, 24" BEECH, N56°E, 24 LKS. (15.84'); 5" BEECH, S50 1/2°W, 11LKS (7.26')
 1906, SURVEY BK. #1, PG. 256, BY B.L. CAUKIN DEPT. CO. SURVEYOR; SET BURIED OLD GLASS AND CROCKERY AT SINGLE PROPORTION MEAS.;
 NO ACCESSORIES.
 1907, RESURVEY BK. 1, PG. 268, BY F.S. CHURCH CO. SURVEYOR, FD A BROKEN STEEL PLOW BEAN ON END WITH STONWARE AND BOTTLES
 AROUND IT.
 1909, SURVEY BK #1, PG. 300, BY F.S. CHURCH CO. SURVEYOR, NO DESCRIPTION OR ACCESSORIES, ONLY NOTE TO SEE PG. 268.
 1973, SURVEY RECORDED IN LIB. 204, PG. 303 AND LCRC. RECORDED IN LIB. 204, PG. 301, BY P.E. CHENARD FD STEEL PLOW BEAM, 2' N. OF RD
 CENTERLINE 13" C. ELM, S53°E, 71.64'; 15" C. ELM, S45°E, 70.47'; 4" SQ. CONCRETE MON. S48°W, 46.42'
 1993, SURVEY REC. IN LIB. 394, PG. 640; BY B.M. JONES, FD 1" IRON, P. POLE, N35°W, 47.80'; FEN. POST, S37°W, 42.20'; 28" MAPLE, S59°E,
 34.43' 18" APPLE, N66°E, 72.40

B. Description of corner evidence found and/or method applied in restoring or reestablishing corner:
M-6, 1/4 CORNER COMMON TO SEC. 13, T31N-R8W & A-6, SEC. 18, T31N-R7W
 1 1/2" X 2 1/2" IRON PLOW BEAM IN CENTERLINE E-W ASPH. ROAD & 11' W. OF GR. ROAD N-S
 PULLED & REPLACED WITH ANTRIM COUNTY MONUMENT (BERNTSEN MODEL G-1 [30" PISTON] WITH G-2 CAP).
 FD. NAIL ON SIDE POWER POLE, N40°W, 47.70' (R. 47.80)
 FD. NAIL ON SIDE CLUMP OF 5-5" APPLE, N61°E, 72.40' (R. 72.40')
 FD. NAIL IN FACE PHONE POLE, S45°W, 42.22 (R. 42.20')
 FD. BROKEN & BENT SQ. CONC. MON. (STRAIGHTENED SAME), S52°W, 46.31' (R. 46.42')
 NO G.L.O. WITNESS WERE FOUND.

C. Description of monument for corner and accessories established to perpetuate locating the position of the corner:
M-6, 1/4 CORNER COMMON TO SEC. 13, T31N-R8W & A-6, SEC. 18, T31N-R7W
 FD. 1 1/2" X 2 1/2" IRON PLOW BEAM IN CENTERLINE E-W ASPH. ROAD & 11' W. OF GR. ROAD N-S
 REPLACED WITH ANTRIM COUNTY MONUMENT.
 FD. NAIL ON SIDE POWER POLE, N40°W, 47.70' (R. 47.80)
 FD. NAIL ON SIDE CLUMP OF 5-5" APPLE, N61°E, 72.40' (R. 72.40')
 FD. NAIL IN FACE PHONE POLE, S45°W, 42.22 (R. 42.20')
 FD. BROKEN & BENT SQ. CONC. MON. (STRAIGHTENED SAME), S52°W, 46.31' (R. 46.42')
 SET NAIL IN SIDE 19" MAPLE, S54°E, 85.10'

Ratified by Peer
 Group in accordance
 with P.A. 345
 Antrim Co. Chairman

 Arthur L. Lennox
 Nov. 18, 1997



Signed by Richard J. Kral
 Surveyor's Michigan License No. 26200

Date 12-14-97