

SURVEY & REMONUMENTATION

FEB 11 1998

Liber 00002 Page 0437

SECTION

LAND CORNER RECORDATION CERTIFICATE
Filing Requirement of Act 74, Mich. P.A. 1970

ANTRIM COUNTY MI.
Register of Deeds
Recorded

For corners in

CENTRAL LAKE

ANTBIM
(County)

Located In: Corner Code #

12-22-1997 10:12:26

- 1. Public Land Survey E 1/4 T.31N R.8W M-8
SEC 14 T.31N R.7W A-8
T. R.
T. R.
- 2. Property Controlling S. T. R.
in Section S. T. R.
- 3. Miscellaneous S. T. R.
Property in Sec. S. T. R.

Wanda R. Conway
REGISTER OF DEEDS

Register of Deeds Stamp & File Number

- 4. Lot No. _____, Recorded Plat _____
- 5. Private Claims _____

I, RICHARD J. KRAL, in a field survey on 9-15-97, 1997 do hereby state that under requirements of P.A. 74, Michigan P.A. of 1970, the corner points mentioned in lines 1 and 2 above were in conformance with regulations and rules therefore as required in the current manual of survey instructions of the United States Department of the Interior, Bureau of Land Management or by a decree of a Court of Law and /or that the corner points mentioned in lines 3, 4 and 5 above were in conformance with the rules of the Michigan Board of Land Surveyors or by a Decree of a Court of Law; established, re-established, monumented, recovered, found as expressed below:

	A	B	C	D	E	F	G	H	I	J	K	L	M
1													
2	6		5		4		3		2		1		
3													
4	7		8		9		10		11		12		
5													
6	18		17		16		15		14		13		
7													
8	19		20		21		22		23		24		
9													
10	30		29		28		27		26		25		
11													
12	31		32		33		34		35		36		
13													

NOTE: Not more than 2 corners, all in the same town and range, may be recorded on this certificate.

A. Description of original monument and accessories and/or subsequent restoration:

- M-8, 1/4 CORNER COMMON TO SEC. 24, T31N-R8W & A-8, SEC. 19, T31N-R7W
1856, RESURVEY TWP. BOUNDARY BY E.D. ATWATER; SET CORNER, 14" SUGAR, N54 1/2°W, 8 LKS. (5.28'); 24" ELM, S69 3/4°E, 9 LKS. (5.94')
1907, SURVEY BK. #1, PG. 275, BY F.S. CHURCH, CO. SURVEYOR, FD LOCATION AN SET STAKE IN ROAD.
1977, LCRC. RECORDED IN LIB. 233, PG. 815, BY A. LENNOX, CO. SURVEYOR, FD 1/2" IRON BAR; 6" ELM EAST, 47.25'; 8" BASSWOOD S75°W, 49.60'; U.POLE S40°W, 59.40'.
1994, LCRC. RECORDED IN LIB. 2, PG. 197, BY A. LENNOX, CO. SURVEYOR, NO DESCRIPTION OF CORNER, U.POLE, S40°W, 59.40'; 8" MAPLE, WEST 52.00'; 6" ELM, N45°E, 39.70'.
1994, SURVEY RECORDED IN LIB. 215, PG. 566, BY M.C. FEINDT, NO DESCRIPTION OF CORNER 5" ELM, EAST, 47.30'; P.POLE, S40°W, 59.80'; 7" BASSWOOD S70°W, 90.00'.

B. Description of corner evidence found and/or method applied in restoring or reestablishing corner:

- M-8, 1/4 CORNER COMMON TO SEC. 24, T31N-R8W & A-8, SEC. 19, T31N-R7W
FD. 1/2" IRON ROD, 1' EAST OF CENTERLINE N-S GR. ROAD, 16' NORTH OF OLD FENCE LINE THROUGH TREES TO WEST PULLED & REPLACED WITH ANTRIM COUNTY MONUMENT (BERNTSEN MODEL G-1 [30" PISTON] WITH G-2 CAP).
FD. FACE OF 6" ELM STUMP S82°E 47.1' (R. 46.30')
FD. CUT OFF P. POLE S41°W 60.0' (R. 59.80')
FD. TO FACE OF 14" MAPLE S76°W, 89.08' (R. 90.00')
FD. BLAZED 14" MAPLE S83°E 51.2'
FD. BLAZED 10" ELM N58°E, 39.38'
NO G.L.O. WITNESS WERE FOUND.


C. Description of monument for corner and accessories established to perpetuate locating the position of the corner:

- M-8, 1/4 CORNER COMMON TO SEC. 24, T31N-R8W & A-8, SEC. 19, T31N-R7W
FD. 1/2" IRON ROD, 1' EAST OF CENTERLINE N-S GR. ROAD, 16' NORTH OF OLD FENCE LINE THROUGH TREES TO WEST PULLED & REPLACED WITH ANTRIM COUNTY MONUMENT.
FD. FACE OF 6" ELM STUMP S82°E 47.1' (R. 46.30')
FD. CUT OFF P. POLE S41°W 60.0' (R. 59.80')
FD. TO FACE OF 14" MAPLE S76°W, 89.08' (R. 90.00')
FD. BLAZED 14" MAPLE S83°E 51.2'
FD. BLAZED 10" ELM N58°E, 39.38'
SET NAIL IN 6" ELM, N43°W, 82.29'

Ratified by Peer
Group in accordance
with P.A. 345
Antrim Co. Chairman

Arthur L. Lennox

Arthur L. Lennox
Nov. 18, 1997

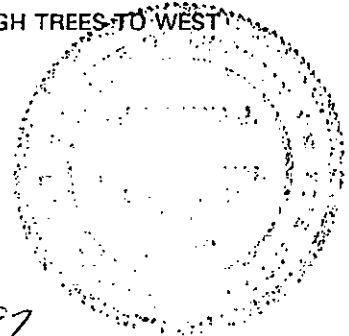

Signed by Richard J. Kral
Surveyor's Michigan License No. 26460

Date 12-14-97