

SURVEY & REMONUMENTATION

FEB 11 1998

Liber 00002 Page 0438

LAND CORNER RECORDATION CERTIFICATE

Filing Requirement of Act 74, Mich. P.A. 1970 ANTRIM COUNTY MI.

SECTION

For corners in

CENTRAL LAKE

ANTRIM _____
(County)

Located In:

Corner Code #

- 1. Public Land Survey SE T.31N R.8W M-9
SEC 24 T.31N R.7W A-9
T. _____ R. _____
T. _____ R. _____
- 2. Property Controlling S. _____ T. _____ R. _____
in Section S. _____ T. _____ R. _____
- 3. Miscellaneous S. _____ T. _____ R. _____
Property in Sec. S. _____ T. _____ R. _____

Register of Deeds
Recorded

12-22-1997 10:12:36

Wanda R. Conway
REGISTER OF DEEDS

Register of Deeds Stamp & File Number

4. Lot No. _____, Recorded Plat _____

5. Private Claims _____

I, RICHARD J. KRAL, in a field survey on 9-15-97, 1997 do hereby state that under requirements of P.A. 74, Michigan P.A. of 1970, the corner points mentioned in lines 1 and 2 above were in conformance with regulations and rules therefore as required in the current manual of survey instructions of the United States Department of the Interior, Bureau of Land Management or by a decree of a Court of Law and for that the corner points mentioned in lines 3, 4 and 5 above were in conformance with the rules of the Michigan Board of Land Surveyors or by a Decree of a Court of Law; established, re-established, monumented, recovered, found as expressed below:

NOTE: Not more than 2 corners, all in the same town and range, may be recorded on this certificate.


	A	B	C	D	E	F	G	H	I	J	K	L	M
1													
2	6		5		4		3		2		1		
3													
4	7		8		9		10		11		12		
5													
6	18		17		16		15		14		13		
7													
8	19		20		21		22		23		24		
9													
10	30		29		28		27		26		25		
11													
12	31		32		33		34		35		36		
13													

A. Description of original monument and accessories and/or subsequent restoration:
M-9, CORNER COMMON TO SECTION 24 & 25, T31N-R8W & A-9 SEC.'S 19 & 30, T31N-R7W
 1856, RESURVEY TWP. BOUNDARY BY E.D. ATWATER; SET CORNER, BEECH 16" S43 1/2°W, 24 LKS. (15.84'); SUGAR 18" N42 1/2°W, 43 LKS. (28.38') ALSO BEECH, 9" N62 1/2°E, 30 LKS. (19.80'); HEMLOCK 13" S12 3/4°E, 59 LKS (38.94')
 1902, SURVEY BK #1, PG. 275, BY F.S. CHURCH CO. SURVEYOR, FD DECAYED STAKE & STUMP OF BEECH 9" N62 1/2°E 30 LKS. (19.80') AND PUT IN NEW STAKE.
 1907, SURVEY BK #1, PG. 275 BY F.S. CHURCH CO. SURVEYOR, MARKED BIRCH 16", S66 1/2°E, 54 LKS. (35.64').
 1912, SURVEY BK #1, PG. 331 BY F.S. CHURCH CO. SURVEYOR, FD STAKE AND BIRCH 16" S66 1/2°E, 54 LKS. (33.64') REPLACED STAKE WITH 5/8" X 36" ROD WITH A SQUARE HEAD ON TOP.
 1977, SURVEY RECORDED IN LIB. #233, PG. 808, BY A. LENNOX, CO. SURVEYOR, FD. 1/2" BAR; U.P. N45°E, 54.15'; 24" MAPLE WEST, 23.02'; 24" MAPLE S30°W, 99.70'.
 1977, LCRC. RECORDED IN LIB. #233, PG. 815, BY A. LENNOX CO. SURVEYOR, FD 1/2" BAR; ACCESSORIES SAME AS SURVEY ABOVE.

B. Description of corner evidence found and/or method applied in restoring or reestablishing corner:
M-9, CORNER COMMON TO SECTION 24 & 25, T31N-R8W & A-9 SEC.'S 19 & 30, T31N-R7W
 FD. 1/2" IRON ROD 3' WEST OF CENTERLINE N-S GR. ROAD, 12' S. OF DRIVE TO EAST
 PULLED & REPLACED WITH ANTRIM COUNTY MONUMENT (BERNTSEN MODEL G-1 [30" PISTON] WITH G-2 CAP).
 FD. PK. NAIL IN SW FACE P.POLE N42°E, 54.15 (R. 54.15)
 FD. DECAYED 30" MAPLE STUMP N80°W, 23.0' (R. 23.02')
 FD. DECAYED 30" MAPLE STUMP S20°W 100.0' (R. 99.70')
 NO G.L.O. WITNESS WERE FOUND.

C. Description of monument for corner and accessories established to perpetuate locating the position of the corner:
M-9, CORNER COMMON TO SECTION 24 & 25, T31N-R8W & A-9 SEC.'S 19 & 30, T31N-R7W
 FD. 1/2" IRON ROD 3' WEST OF CENTERLINE N-S GR. ROAD, 12' S. OF DRIVE TO EAST
 PULLED & REPLACED WITH ANTRIM COUNTY MONUMENT.
 FD. PK. NAIL IN SW FACE P.POLE N42°E, 54.15 (R. 54.15)
 SET SPIKE ON NE SIDE P. POLE, N23°W 69.83'
 SET SPIKE ON SIDE OF 11" R. PINE, S82°E, 87.21'
 SET SPIKE ON SIDE 30" CH. ELM, S41°E, 95.92'

Ratified by Peer
Group in accordance
with P.A. 345
Antrim Co. Chairman
Arthur L. Lennox
Arthur L. Lennox
Nov. 18, 1997

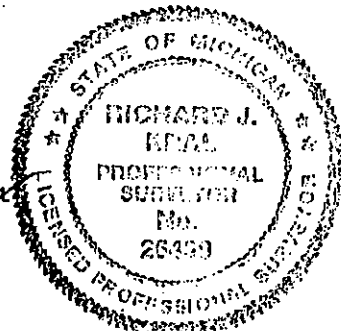

Signed by Richard J. Kral
Surveyor's Michigan License No. 26460

Date 12-14-97