

APR 06 1999

SECTION

ARENAC COUNTY REMONUMENTATION LAND CORNER RECORDATION CERTIFICATE Filing Requirement of Act 74, Mich. P.A. 1970

For corners in

ARENAC COUNTY (County)

Located In:

Corner Code

Page 1 of 1 ROSE SMITH

LC 2/168 1P

ARENAC CO. REG. OF DEEDS

RS Rec. Date 12/29/98 Time 10:51

RECORDING FEES:

9.00

- 1. Public Land Survey T 18N R 4E T 18N R 3E T R T R
2. Property Controlling in Section S T R S T R
3. Miscellaneous Property in Sec. S T R S T R

- A-4 M-4

Register of Deeds Stamp & File Number

4. Lot No. , Recorded Plat

5. Private Claims

I, DALE L. WINIECKE, in a field survey on AUGUST 3, 1998 do hereby state that under requirements of P.A. 74, Michigan P.A. of 1970, the corner points mentioned in lines 1 and 2 above were in conformance with regulations and rules therefore as required in the current manual of survey instructions of the United States Department of the Interior, Bureau of Land Management or by a decree of a Court of Law and /or that the corner points mentioned in lines 3, 4 and 5 above were in conformance with the rules of the Michigan Board of Land Surveyors or by a Decree of a Court of Law; established, re-established, monumented, recovered, found as expressed below:

NOTE: Not more than 2 corners, all in the same Town and Range, may be recorded on this certificate.

Grid table with columns A-M and rows 1-13. Contains numbers 1-36 in a grid pattern.

A. Description of original monument and accessories and/or subsequent restoration:

- A-4
1. ORIGINAL POST SET BY L. CLASON IN 1837 12" PINE S36°W 24 LINKS 12" ELM N38°W 16 LINKS
2. CORNER ESTABLISHED WHEN HIGHWAY WAS LAID OUT PER COUNTY SURVEYOR NOTES BY G. TURNER, 1904.
3. LCRC, L. 1, P. 141; A-4 T18N, R4E, ARENAC CO., J. SEDGMAN, PS# 18664 (1980), FOUND IRON RLS CAP
4. CERTIFICATE OF SURVEY, L. 1, P. 415 A-4 T18N, R4E; ARENAC CO., J. SEDGMAN, PS#18664, (1980), FOUND IRON RLS CAP

B. Description of corner evidence found and/or method applied in restoring or reestablishing corner:


A-4
SEARCHED THE APPARENT LOCATION OF THE CORNER AND FOUND A 3/8" REROD. AT 0.90' BELOW THE GRAVEL SURFACE A 1" x 1" x 21" LONG SQUARE IRON WAS FOUND. AT 1.4' BELOW THE ROAD SURFACE A 1.5' x 1.5' BOULDER WAS FOUND 0.5' SOUTH OF THE 3/8" REROD AND SQUARE IRON.
NO WITNESSES REMAIN FROM THE ABOVE RECORDED INFORMATION.
ACCEPTED THE 1" x 1" x 21" LONG IRON AS THE BEST EVIDENCE OF THE POSITION OF THE ORIGINAL CORNER. CORNER A-4 IS COMMON WITH M-4, T18N, R3E BAY COUNTY.

C. Description of monument for corner and accessories established to perpetuate locating the position of the corner:

A-4
REPLACED 1" x 1" x 21" LONG IRON WITH 5/8" x 24" LONG REBAR WITH BAY/ARENAC COUNTY REMONUMENTATION CAP IN MONUMENT BOX N50°W 30.20' TO TOP CENTER OF TELEPHONE RISER N45°E 37.30' TO TOP CENTER OF TELEPHONE RISER S85°E 197.60' TO NAIL AND TAG IN NW FACE OF 36" MAPLE S45°W 80.10' TO NAIL AND TAG IN NW FACE POWER POLE EAST 4.0' TO PHYSICAL CENTERLINE OF EIGHT MILE ROAD SOUTH 5.0' TO PHYSICAL CENTERLINE OF JOHNSFIELD ROAD

Signed by Dale Winiecke
Surveyor's Michigan License No. 41915

Date 12/28/98

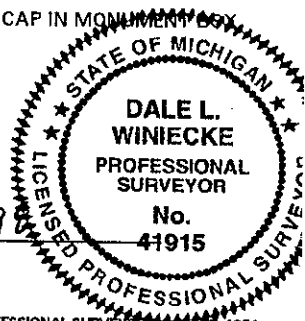

ACCEPTED BY THIS ARENAC COUNTY SURVEY PIER GROUP AS THE OFFICIAL CORNER UNDER MICHIGAN PUBLIC ACT 345 OF 1990 AT A MEETING HELD ON 10 Nov. 1998 Paul M. Ciosek PS, CHAIRMAN