

Arenac County Remonumentation
LAND CORNER RECORDATION CERTIFICATE
 Filing Requirement of Act 74, Mich. P.A. 1970

LIBER 2 PAGE 76

For corners in

Arenac <small>(County)</small>	Located in:	Corner Code #
1. Public Land Survey	T <u>18N</u> R <u>4E</u>	<u>A-5</u>
	T _____ R _____	_____
	T _____ R _____	_____
	T _____ R _____	_____
2. Property Controlling in Section	S _____ T _____ R _____	_____
	S _____ T _____ R _____	_____
3. Miscellaneous Property in Sec.	S _____ T _____ R _____	_____
	S _____ T _____ R _____	_____

RECORDED

JAN 2 11 14 AM '97

ARENAC COUNTY
REGISTER OF DEEDS

Register of Deeds Stamp & File Number

4. Lot No. _____, Recorded Plat _____
 5. Private Claims _____

I, Michael J. MacDonald, in a field survey on July 26, 1996 do hereby state that under requirements of P.A. 74, Michigan P.A. of 1970, the corner points mentioned in lines 1 and 2 above were in conformance with regulations and rules therefore as required in the current manual of survey instructions of the United States Department of the Interior, Bureau of Land Management or by a decree of a Court of Law and/or that the corner points mentioned in lines 3, 4 and 5 above were in conformance with the rules of the Michigan Board of Land Surveyors or by a Decree of a Court of Law; established, re-established, monumented, recovered, found as expressed below:


NOTE: Not more than 2 corners, all in the same town and range, may be recorded on this certificate.

1	A	B	C	D	E	F	G	H	I	J	K	L	M
2	6	5	4	3	2	1							
3													
4	7	8	9	10	11	12							
5													
6	18	17	16	15	14	13							
7													
8	19	20	21	22	23	24							
9													
10	30	29	28	27	26	25							
11													
12	31	32	33	34	35	36							
13													

A. Description of original monument and accessories and/or subsequent restoration:

A-5 Post set by L. Clason D.S. in 1837.
 County Surveyor G. Turner in 1904 states that corner was established when highway was laid out.
 County Surveyor G. Turner in 1908 fnd post set by former Co. Surveyor.

L.C.R.C. - L. 1, P. 235 by T. Lapham - fnd 1/2" Iron.
 Survey by Norstar in April 1992 - fnd 1/2" Iron.

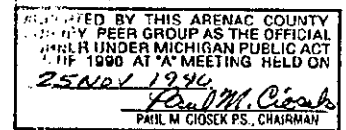

B. Description of corner evidence found and/or method applied in restoring or reestablishing corner:

A-5 Fnd 1/2" rebar.


Recorded Witnesses as follows:
 N 30° W 77.50' to MI Bell Riser - meas 77.50' to nail in wood pole next to riser.
 N 75° W 82.73' to Load Limit sign.
 S 45° W 82.95' to P.P. - measured 82.94' to nail and disk in pole.
 Monument accepted as the best available evidence of the position of the original corner.

SURVEY &
 REMONUMENTATI
 MAY 20 1997
 COMMISSION

C. Description of monument for corner and accessories established to perpetuate locating the position of the corner:

A-5 Replaced 1/2" rebar with 5/8" x 24" rebar with Arenac County Remonumentation cap.

W 207.55' to nail and tag in N face of 4" x 4" cor wood fence post.
 N 15° E 115.15' to 3/8" Iron and cap set in shoulder of road.
 S 50° W 169.38' to NW cor of stone fascia of Hse #11.
 S 50° W 128.06' to NE cor of stone fascia of Hse #11.
 S 46° W 82.94' to nail and disk in SE face of transformer pole.

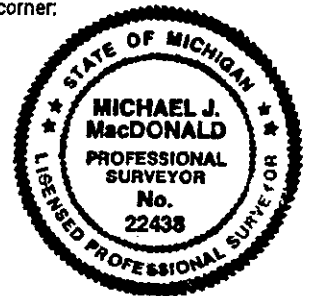

Signed by Michael J. MacDonald
 Surveyor's Michigan License No. 22438

Date 19 Dec 96