

MAY 20 1997

Arenac County Remonumentation

LAND CORNER RECORDATION CERTIFICATE
Filing Requirement of Act 74, Mich. P.A. 1970

LIBER 002 PAGE 078

For corners in

Arenac
(County)

Located In:

Corner Code #

- 1. Public Land Survey T18N R 4E A-7
- T _____
- T _____
- T _____
- 2. Property Controlling S _____ _____
- in Section S _____ _____
- 3. Miscellaneous S _____ _____
- Property in Sec. S _____ _____

ARENAC COUNTY
REGISTER OF DEEDS

JAN 21 11 24 AM '97

RECORDED

Register of Deeds Stamp & File Number

- 4. Lot No. _____, Recorded Plat _____
- 5. Private Claims _____

I, Michael J. MacDonald, in a field survey on July 26, 1996 do hereby state that under requirements of P.A. 74, Michigan P.A. of 1970, the corner points mentioned in lines 1 and 2 above were in conformance with regulations and rules therefore as required in the current manual of survey instructions of the United States Department of the Interior, Bureau of Land Management or by a decree of a Court of Law and/or that the corner points mentioned in lines 3, 4 and 5 above were in conformance with the rules of the Michigan Board of Land Surveyors or by a Decree of a Court of Law; established, re-established, monumented, recovered, found as expressed below:

NOTE: Not more than 2 corners, all in the same town and range, may be recorded on this certificate.

1	A	B	C	D	E	F	G	H	I	J	K	L	M
2		6		5		4		3		2		1	
3													
4		7		8		9		10		11		12	
5													
6		10		17		16		15		14		13	
7													
8		19		20		21		22		23		24	
9													
10		30		29		28		27		26		25	
11													
12		31		32		33		34		35		36	
13													

A. Description of original monument and accessories and/or subsequent restoration:


A-7 Post set by L. Clason in 1837.
County Surveyor G. Turner in 1908 fnd post set by former County Surveyor.
L.C.R.C. - L. 1, P. 325, by T. Lapham - fnd RR rail.
Survey by Norstar in April 1992 - fnd RR rail.

B. Description of corner evidence found and/or method applied in restoring or reestablishing corner:

A-7 Fnd RR rail set vertically.

Recorded Witnesses as follows:

N 10° W 38.08' to nail in 14" Elm (10" - R).
N 80° W 47.54' to nail in 6" Birch.
S 30° W 28.09' to nail in 12" Poplar
S 20° E 30.83' to nail in 8" Maple.
Monument accepted as best available evidence of the position of the original corner.

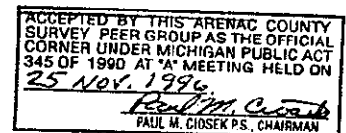

C. Description of monument for corner and accessories established to perpetuate locating the position of the corner:

A-7 Pushed RR rail aside and left in place and set 5/8" x 24" long rebar and Arenac County Remonumentation cap.

N 10° W 38.08' to nail in 14" Elm.
N 80° W 47.54' to nail in 6" Birch.
S 30° W 28.09' to nail in 12" Poplar.
S 20° E 30.83' to nail in 8" Maple.



Signed by Michael J. MacDonald
Surveyor's Michigan License No. 22438

Date 19 Dec 96