

Arenac County Remonumentation

LIBER 02 PAGE 60

LAND CORNER RECORDATION CERTIFICATE  
Filing Requirement of Act 74, Mich. P.A. 1970

For corners in Arenac (County) Located In: \_\_\_\_\_ Corner Code # \_\_\_\_\_


1. Public Land Survey	T <u>18N</u> R <u>4E</u>	<u>E 9</u>
	T _____ R _____	_____
	T _____ R _____	_____
	T _____ R _____	_____
2. Property Controlling in Section	S _____ T _____ R _____	_____
	S _____ T _____ R _____	_____
3. Miscellaneous Property in Section	S _____ T _____ R _____	_____
	S _____ T _____ R _____	_____

4. Lot No. \_\_\_\_\_, Recorded Plat \_\_\_\_\_

5. Private Claims \_\_\_\_\_

RECORDED  
JAN 22 2 06 PM '96  
ARENAC COUNTY REGISTERED DEEDS  
Register of Deeds Stamp & File Number

I, Craig W. McVean, in a field survey on May 24, 1995 do hereby certify that under requirements of P.A. 74, Michigan P.A. of 1970, the corner points mentioned in lines 1 and 2 above were in conformance with regulations and rules therefore as required in the current manual of survey instructions of the United States Department of the Interior, Bureau of Land Management or by a decree of a Court of Law and/or that the corner points mentioned in lines 3, 4 and 5 above were in conformance with the rules of the Michigan Board of Professional Surveyors or by a Decree of a Court of Law; established, re-established, monumented, re-monumented, recovered, found as expressed below:

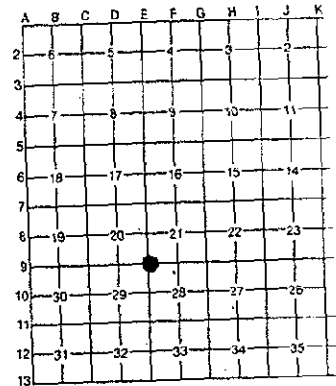

NOTE: Not more than 4 corners, all in the same town and range, may be recorded on this certificate.

A. Description of original monument and accessories and/or subsequent restoration:

E 9 - A Maple 12" in dia. corner to Section 20, 21, 28, and 29 - J. Burt - 1843.  
W. Pine 30" N 85° W 33 Lks.

MDOT Witness Card - L. 1, P. 206 - references to Section c common to 20, 21, 28, 29, T18N, R4E, Arenac County - found hub in nest of broken china and rotten pine stake. (Set 1/2" bar and angle ties to D 9, F 9, E 10, and E 8 - Caldwell - 1964.

Arenac County Surveyor Notes - Found rotten soft Maple stump and original Pine Witness stump. All marks plain, set Cedar post in roots of Maple stump - 1909.

B. Description of corner evidence found and/or method applied in restoring or reestablishing corner:

E 9 - Found 3/4" inner dia. iron pipe - down 0.2' - excavate and find 2 wood stakes and 1 wood hub along side pipe with some White Crockery - remove wood stakes and hub, 3/4" x 2' long iron pipe and find record 1/2" rod inside pipe - find remains of rotten Cedar post per County Surveyor Notes and MDOT Witness Card - down 2'. Leave rotten Cedar post in place and raise with 3" Arenac County brass cap on 5/8" x 24" rebar with 4" plastic sleeve with concrete - down 0.5' - monument accepted as a careful and faithful perpetuation of the position of the original corner.

C. Description of monument for corner and accessories established to perpetuate locating the position of the corner:

E 9 - 3" Arenac County brass cap on 5/8" x 24" rebar with 4" plastic tile sleeve with concrete.  
S 82° E (S 85° E - R) 51.95' (52.12' - R) to MDOT tag in N side P.P.  
S 30° E 37.72' to nail and tag in NE side 24" Elm.  
N 22° E 107.41' to nail and tag in W side 6" Ash.  
N 36° W 46.51' to nail and tag in SW side U.P.  
S 45° W 155.84' to nail and tag in NW side 14" Pine.

ACCEPTED BY THIS ARENAC COUNTY SURVEY PEER GROUP AS THE OFFICIAL CORNER UNDER MICHIGAN PUBLIC ACT 345 OF 1990 AT A MEETING HELD ON 22 Nov. 1995.  
*Paul M. Ciosek*  
PAUL M. CIOSEK P.S., CHAIRMAN



Signed by Craig W. McVean Date 12/19/95  
Surveyor's Michigan License No. 39088