

SURVEY & REMONUMENTATION

MAR 05 1998

SECTION

For corners in

**ARENAC COUNTY REMONUMENTATION
LAND CORNER RECORDATION CERTIFICATE**

LC 2/ 126
IP

Filing Requirement of Act 74, Mich. P.A. 1970, CD. REG. OF DEEDS

RS Rec. Date 12/23/97 Time 11:36
RECORDING FEES: 9.00

ARENAC <small>(County)</small>	Located In:	Corner Code #	
1. Public Land Survey	T18N R4E	F-5	
	T ___ R ___	_____	
	T ___ R ___	_____	
	T ___ R ___	_____	
2. Property Controlling in Section	S ___ T ___ R ___	_____	
	S ___ T ___ R ___	_____	
3. Miscellaneous Property in Sec.	S ___ T ___ R ___	_____	
	S ___ T ___ R ___	_____	

Register of Deeds Stamp & File Number

4. Lot No. _____, Recorded Plat _____

5. Private Claims _____

	A	B	C	D	E	F	G	H	I	J	K	L
1												
2	6		5		4		3		2		1	
3												
4	7		8		9		10		11		12	
5												
6	18		17		16		15		14		13	
7												
8	19		20		21		22		23		24	
9												
10	30		29		28		27		26		25	
11												
12	31		32		33		34		35		36	
13												

I, MICHAEL J. MACDONALD, in a field survey on SEPTEMBER 15, 1997 do hereby state that under requirements of P.A. 74, Michigan P.A. of 1970, the corner points mentioned in lines 1 and 2 above were in conformance with regulations and rules therefore as required in the current manual of survey instructions of the United States Department of the Interior, Bureau of Land Management or by a decree of a Court of Law and/or that the corner points mentioned in lines 3, 4 and 5 above were in conformance with the rules of the Michigan Board of Land Surveyors or by a Decree of a Court of Law; established, re-established, monumented, recovered, found as expressed below:

NOTE: Not more than 2 corners, all in the same town and range, may be recorded on this certificate.

A. Description of original monument and accessories and/or subsequent restoration:

- F-5
- 1. ORIGINAL POST SET JULY 1843, J. BURT D.S.
ASPEN 22° S 25° E 10 LINKS
HEMLOCK 8° N 18° W 38 LINKS
- 2. LCRC L 1, P 30 (3/79) SEDGMAN, FOUND 3/8" BAR
- 3. SURVEY, L 1, P 450-456 (10/79) R. HIGGINS, FOUND 3/8" REROD OF RECORD
- 4. LCRC, L 2, P 17 (12/17/93) RUDELL, FOUND 3/8" REROD PER SURVEY, L 1, P 450-456
- 5. SURVEY, L 2, P 60,61 (12/17/93) RUDELL, FOUND 3/8" REROD

B. Description of corner evidence found and/or method applied in restoring or reestablishing corner:

F-5
SEARCHED THE APPARENT LOCATION AND FOUND 3/8" REROD. EXCAVATED UNDER THE 3/8" x 18" REROD AND FOUND NO OTHER OBJECTS. ACCEPTED THE 3/8" REROD AS THE BEST AVAILABLE EVIDENCE OF THE POSITION OF THE ORIGINAL CORNER.


C. Description of monument for corner and accessories established to perpetuate locating the position of the corner:

F-5
REPLACED THE 3/8" REROD WITH A 5/8" x 24" LONG REROD WITH ARENAC CO. REMONUMENTATION CAP WITH 1/8" DRILL HOLE.
N 10° E 24.16' (24.1' R.) FND NAIL AND TAG PS #14769 W. FACE 4" ELM
S 50° E 5.08' (5.0' R.) W. EDGE LEG OF SIGN
S 10° E 5.05' TO NORTH EDGE OF SIGN LEG
S 20° W 123.15' (123' R.) FOUND N/T #18664 IN W. FACE U. POLE
N 70° W 12.45 SET N/T S. FACE 5" ASH

Signed by Michael J. MacDonald

Surveyor's Michigan License No. 22438

FIELD BOOK 2, PAGE 44

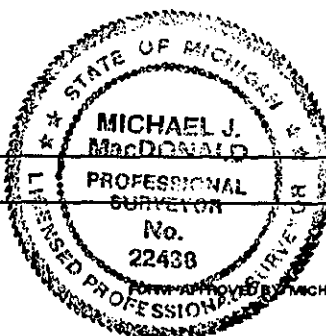

Date 18 Dec 97

ACCEPTED BY THIS ARENAC COUNTY SURVEY PEER GROUP AS THE OFFICIAL CORNER UNDER MICHIGAN PUBLIC ACT 345 OF 1890 AT 'A' MEETING HELD ON 10/30/97
Paul M. Ciosek
PAUL M. CIOSEK P.S., CHAIRMAN