

APR 06 1999

SECTION

ARENAC COUNTY REMONUMENTATION LAND CORNER RECORDATION CERTIFICATE Filing Requirement of Act 74, Mich. P.A. 1970

For corners in

ARENAC (County) Located in: Corner Code # 1. Public Land Survey T 18N R 4E G-8 2. Property Controlling in Section S T R 3. Miscellaneous Property in Sec. S T R

Page 1 of 1 ROSE SMITH ARENAC CO. REG. OF DEEDS Rec. Date 12/29/98 RECORDING FEES: 9.00 LC 2/ 179 1P Time 10:51

Register of Deeds Stamp & File Number

4. Lot No. , Recorded Plat 5. Private Claims

I, DALE L. WINIECKE, in a field survey on JULY 30, 1998 do hereby state that under requirements of P.A. 74, Michigan P.A. of 1970, the corner points mentioned in lines 1 and 2 above were in conformance with regulations and rules therefore as required in the current manual of survey instructions of the United States Department of the Interior, Bureau of Land Management or by a decree of a Court of Law and for that the corner points mentioned in lines 3, 4 and 5 above were in conformance with the rules of the Michigan Board of Land Surveyors or by a Decree of a Court of Law; established, re-established, monumented, recovered, found as expressed below:

NOTE: Not more than 2 corners, all in the same town and range, may be recorded on this certificate.

Grid table with columns A-M and rows 1-13. A dot is marked at the intersection of column H and row 8.

A. Description of original monument and accessories and/or subsequent restoration:


- G-8 1. ORIGINAL POST SET IN 1834 BY J. BURT, D.S. CEDAR 10" S53°W 4 LINKS HEMLOCK 9" N32°E 3 1/2 LINKS 2. LCRC - L. 1, P. 187, BY N. CALDWELL, PS #12018, (1964), FOUND PINE STAKE AND PLACED LEAF SPRING AND 1/2" PIPE

B. Description of corner evidence found and/or method applied in restoring or reestablishing corner:

G-8 SEARCHED APPARENT LOCATION AND FOUND 1/2" PINCH PIPE. EXCAVATED CORNER AND FOUND LEAF SPRING SOUTHERLY OF POINT. AT 1.5' BELOW GRADE FOUND 3/8" REBAR 0.43' NORTH AND 0.62' EAST OF PIPE. BELOW 3/8" REBAR FOUND WOOD FRAGMENTS, CHECKED WITNESSES FROM L.1, P.187, S58°W TO 24" POPLAR 59.66' (R) TO FACE 36" POPLAR 59.20' (M); N66°W TO 8" ASH 55.34' (R) TO FACE 12" ASH 55.57' (M); N58°E TO 24" POPLAR 38.08' (R) TO FACE 42" POPLAR 37.67' (M); S85°E TO FENCE CORNER POST 33.39' (R) 33.45' (M). 3/8" REBAR ACCEPTED AS THE BEST AVAILABLE EVIDENCE OF THE POSITION OF THE ORIGINAL CORNER.

C. Description of monument for corner and accessories established to perpetuate locating the position of the corner:

G-8 REPLACED 3/8" REBAR WITH 5/8" X 24" LONG REBAR WITH ARENAC COUNTY REMONUMENTATION CAP SOUTHWEST 59.20' TO SET NAIL & TAG IN NORTHWEST FACE OF 36" POPLAR NORTHWEST 55.27' TO SET NAIL & TAG IN NORTH FACE OF 12" ASH NORTHEAST 37.67' TO SET NAIL & TAG IN SOUTH FACE OF 42" POPLAR SOUTHWEST 37.61' TO SET CHISELED 'X' IN TOP OF METAL GUARD RAIL POST NORTHWEST 3.61' TO SET CHISELED 'X' IN TOP OF METAL POST NORTH 0.16' TO FACE OF GUARD RAIL POST

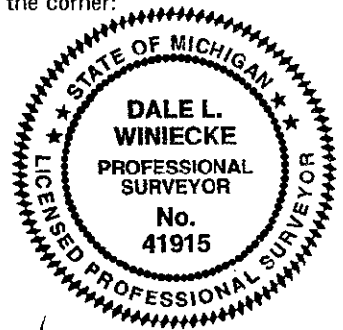

Signed by Dale Winiecke Date 12/28/98 Surveyor's Michigan License No. 41915

FB. 2, P. 70

