

Arenac County Remonumentation

LIBER 02 PAGE 58

LAND CORNER RECORDATION CERTIFICATE  
Filing Requirement of Act 74, Mich. P.A. 1970


|  |                          |               |
|--|--------------------------|---------------|
| For corners in<br><u>Arenac</u><br><small>(County)</small> | Located In:              | Corner Code # |
| 1. Public Land Survey                                      | T <u>18N</u> R <u>4E</u> | <u>G 9</u>    |
|  | T _____ R _____          | _____         |
|  | T _____ R _____          | _____         |
| 2. Property Controlling<br>in Section                      | S _____ T _____ R _____  | _____         |
|  | S _____ T _____ R _____  | _____         |
| 3. Miscellaneous<br>Property in Section                    | S _____ T _____ R _____  | _____         |
|  | S _____ T _____ R _____  | _____         |
| 4. Lot No. _____, Recorded Plat _____                      |                          |               |
| 5. Private Claims _____                                    |                          |               |

ARENAC COUNTY  
REGISTER OF DEEDS  
 Jan 2 2 12 PM '95

RECORDED

Register of Deeds Stamp & File Number

I, Craig W. McVean, in a field survey on May 24, 1995  
do hereby certify that under requirements of P.A. 74, Michigan P.A. of 1970, the corner points mentioned in lines 1 and 2 above were in conformance with regulations and rules therefore as required in the current manual of survey instructions of the United States Department of the Interior, Bureau of Land Management or by a decree of a Court of Law and/or that the corner points mentioned in lines 3, 4 and 5 above were in conformance with the rules of the Michigan Board of Professional Surveyors or by a Decree of a Court of Law; established, re-established, monumented, re-monumented, recovered, found as expressed below:

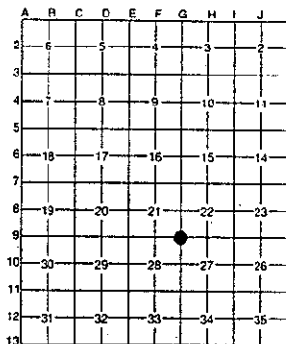

NOTE: Not more than 4 corners, all in the same town and range, may be recorded on this certificate.

A. Description of original monument and accessories and/or subsequent restoration:


G 9 - Set Post - J. Burt - 1843  
Pine 24" N 40° W 21 Lks.  
Do. 18" S 6 1/2° E 22 Lks.

MDOT Witness Card - L. 1, P. 207 - References to Section corner common to 21, 22, 27, 28, T18N, R4E, found old 3" x 3" stake and 2 small bolts, placed auto tie rod along side (recorded corner) dist. and angle ties to F 9, G 8, and H 9 - Caldwell - 1964

Arenac County Survey Notes - Reference to corner with dist. ties to G 8 and H 9 - 1904.

B. Description of corner evidence found and/or method applied in restoring or reestablishing corner:

G 9 - Found auto tie rod with stones along S side. Remove tie rod and find 2 small bolts, wood stake and glass along side and below 1' per MDOT Witness Card. Replace tie rod and bolts with 3" Arenac County brass cap on 5/8" x 24" rebar with 4" plastic tile sleeve with concrete with large 1.5' x 1.5' boulder in place on S side and stones placed around monument - down 0.5'. Monument accepted as the best available evidence of the position of the original corner.

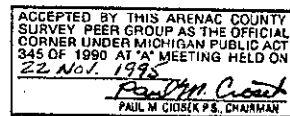

C. Description of monument for corner and accessories established to perpetuate locating the position of the corner:

G 9 - 3" Arenac County brass cap on 5/8" x 24" rebar with 4" plastic tile sleeve with concrete.  
S 36° E 44.40' to capped 3/8" rebar.  
S 60° W 28.30' to "x" on S end 12" concrete pipe.  
N 68° W 70.35' to nail and tag in S side U.P.  
N 25° W 56.88' to set nail and tag over found nail in NE side 36" Elm.  
N 10° W 99.90' to nail and tag in E side 6" Oak.



Signed by Craig W. McVean Date 12/20/95  
Surveyor's Michigan License No. 39088

FEB 29 1996