

**SURVEY & REMONUMENTATION**

MAR 05 1998

**SECTION**

**ARENAC COUNTY REMONUMENTATION  
LAND CORNER RECORDATION CERTIFICATE  
Filing Requirement of Act 74, Mich. P.A. 1970**

For corners in

Arenac  
(County)

Located In:

Corner Code #

Page 1 of 1  
ROSE SMITH LC 2/ 136  
ARENAC CO. REG. OF DEEDS  
RS Rec. Date 12/23/97 Time 11:42  
RECORDING FEES: 9.00

- |                                    |                          |            |
|------------------------------------|--------------------------|------------|
| 1. Public Land Survey              | T <u>18N</u> R <u>4E</u> | <u>H-5</u> |
|                                    | T ___ R ___              | _____      |
|                                    | T ___ R ___              | _____      |
|                                    | T ___ R ___              | _____      |
| 2. Property Controlling in Section | S ___ T ___ R ___        | _____      |
|                                    | S ___ T ___ R ___        | _____      |
| 3. Miscellaneous Property in Sec.  | S ___ T ___ R ___        | _____      |
|                                    | S ___ T ___ R ___        | _____      |

Register of Deeds Stamp & File Number

4. Lot No. \_\_\_\_\_, Recorded Plat \_\_\_\_\_

5. Private Claims \_\_\_\_\_

	A	B	C	D	E	F	G	H	I	J	K	L	M
1													
2	6		5		4		3		2		1		
3													
4	7		8		9		10		11		12		
5													
6	18		17		16		15		14		13		
7													
8	19		20		21		22		23		24		
9													
10	30		29		28		27		26		25		
11													
12	31		32		33		34		35		36		
13													

I, MICHAEL J. MACDONALD, in a field survey on SEPTEMBER 15, 1997 do hereby state that under requirements of P.A. 74, Michigan P.A. of 1970, the corner points mentioned in lines 1 and 2 above were in conformance with regulations and rules therefore as required in the current manual of survey instructions of the United States Department of the Interior, Bureau of Land Management or by a decree of a Court of Law and /or that the corner points mentioned in lines 3, 4 and 5 above were in conformance with the rules of the Michigan Board of Land Surveyors or by a Decree of a Court of Law; established, re-established, monumented, recovered, found as expressed below:

NOTE: Not more than 2 corners, all in the same town and range, may be recorded on this certificate.

A. Description of original monument and accessories and/or subsequent restoration:

H-5

- POST SET J. BURT D.S. IN 1843  
HEMLOCK 20" N 45°E 20 LINKS  
HEMLOCK 13" S 85°W 20 LINKS
- SURVEY, L 1, P 8, (10/71) DE LA MATER, FND 1/2" IRON; N 5°E, 53.15' TO PP; S 5° E, 24.4' TO TP; S 45° W, 48.75" TO MAPLE
- SURVEY, L 1, P 69, (3/73) MCGINNIS, FOUND 1/2' REROD; N 5°E, 53.15' TO PP; S 5° E, 24.4' TO TP; S 45° W, 48.75" TO MAPLE
- SURVEY, L 1, P 207 (7/24/75) SEDGMAN, FOUND 3/8" BAR (BENT) RESET CAPPED 1/2" IRON; N 10°E, 53.59' PP; S 6545° E, 87.80', FENCE POST; SOUTH 32.78' COR FENCE POST
- LCRC, L 1, P 85 (7/24/75) SEDGMAN, FOUND 3/8" BAR (BENT) RESET CAPPED 1/2" IRON; N 10°E, 53.59' PP; S 6545° E, 87.80', FENCE POST; SOUTH 32.78' COR FENCE POST
- UNRECORDED SURVEY, BURGIN (#29240), 4/23/88, FOUND SPIKE, REPLACED WITH CAPPED T-IRON, #29240
- SURVEY, L 2, P 47 (9/93) RUDDLELL, FND 1/2" IRON RLS 29420  
LCRC L 1, P 330 (9/2/93) RUDDLELL, FND 1/2" IRON RLS 29420 ACCORDING TO LCLR L.1, P. 85

B. Description of corner evidence found and/or method applied in restoring or reestablishing corner:



H-5

SEARCHED THE APPARENT LOCATION OF THE CORNER AND FOUND A T-IRON RLS # 29240. WITNESSES FIT SURVEY L. 2, P. 47 AND LCRC L. 1, P. 330 AND LCRC L. 1, P. 85. CAPPED T-IRON ACCEPTED AS THE BEST AVAILABLE EVIDENCE OF THE POSITION OF THE ORIGINAL CORNER.

C. Description of monument for corner and accessories established to perpetuate locating the position of the corner:

H-5

REPLACED THE T-IRON RLS #29240 WITH 5/8" x 24" LONG REROD WITH ARENAC CO. REMONUMENTATION CAP WITH 1/8" DRILL HOLE.  
N 10° E, 53.07' (53.02' R.) N&C IN W. SIDE P.P.  
S 60°E, 42.78' SET N & T EAST END 18" CMP  
SOUTH 31.09' (31.1' R.) FND N & T IN EAST FACE 10" PINE  
S 40° W 39.74' (39.74' R.) FND N & T NW FACE 15" PINE

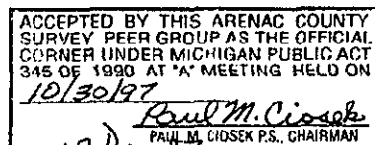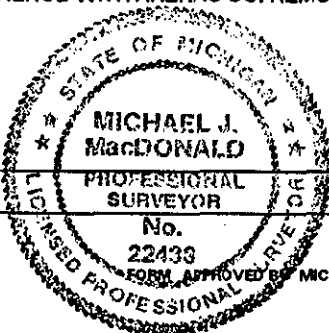

Signed by Michael J. MacDonald

Surveyor's Michigan License No. 22438

FIELD BOOK 2, PAGE 46

Date 10 Dec 97