SURVEY &
REMONUMENTATION

MAR 05 1998

SECTION

LAND CORNER RECORDATION CERTIFICATE
Filing Requirement of Act 74, Mich. P.A. 1970

Page 1 of 1 LC 2/ 135
ROSE SMITH 1P
ARENAC CO. REG. OF DEEDS
RS Rec. Date 12/23/97 Time 11:41
RECORDING FEES: 9.00

For corners in

ARENAC
(County)

	Located In:			Corner Code #
1. Public Land Survey		T18N	R 4E	I-5
		T____	R____	
		T____	R____	
		T____	R____	
2. Property Controlling	S____	T____	R____	
in Section	S____	T____	R____	
3. Miscellaneous	S____	T____	R____	
Property in Sec.	S____	T____	R____	

Register of Deeds Stamp & File Number

4. Lot No. _____ , Recorded Plat _____

5. Private Claims _____

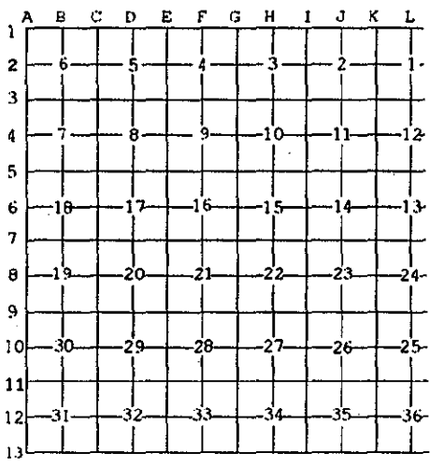

I, MICHAEL J. MACDONALD, in a field survey on SEPTEMBER 15, 19 97 do hereby state that under requirements of P.A. 74, Michigan P.A. of 1970, the corner points mentioned in lines 1 and 2 above were in conformance with regulations and rules therefore as required in the current manual of survey instructions of the United States Department of the Interior, Bureau of Land Management or by a decree of a Court of Law and /or that the corner points mentioned in lines 3, 4 and 5 above were in conformance with the rules of the Michigan Board of Land Surveyors or by a Decree of a Court of Law; established, re-established, monumented, recovered, found as expressed below:

NOTE: Not more than 2 corners, all in the same town and range, may be recorded on this certificate.

A. Description of original monument and accessories and/or subsequent restoration:

I-5

1. POST SET J. BURT D.S. IN 1843
HEMLOCK 6" S 71°30' W 13 LINKS
HEMLOCK 6" N 45°E 3 LINKS

2. EDMANDS SURVEY 1965, UNRECORDED, JOB #3405, NO CALL, DISTANCE TO H-5 2643.10' M., 2643.00' R.

3. LCRC, L 1, P 85, (7/24/75) SEDGMAN, FND 3/8" REROD BENT, RESET 1/2" BAR WITH RLS CAP; N 40°W 44.98' TO T.P.; S 55° W 73.62' TO T.P.; S 50° E 48.22' TO 4" WILD CHERRY

4. EDMANDS SURVEY (8/15/77) MCGINNIS, L.1, P. 332, NW 42.0 ROAD SIGN POST (42.00M)

5. EDMANDS SURVEY (10/28/77) MCGINNIS, L.1, P. 336, DISTANCE TO REFERENCE POINT ON OLD M-10 (1533.87R, 1533.68 M.)

6. EDMANDS SURVEY (10/31/77) MCGINNIS, L.1, P. 344, NW 42.0 ROAD SIGN POST (42.00M)

7. EDMANDS SURVEY, L 1, P 559, (6/87) MCGINNIS, FOUND (NO CALL) DISTANCE TO REFERENCE POINT ON OLD M-10 (1533.87R, 1533.68 M.)

8. SURVEY, L 2, P 100 (3/8/95) LAPHAM, FOUND 1/2" IRON; N 22° W 41.73', STOP SIGN POST; N 15° E 98.74', 8" WHITE PINE; N 64° E 111.68', U. POLE; S 10° E 69.61' TO SUGAR MAPLE

9. UNRECORDED MDOT WITNESS CARD (9/95) BOGREN (#38112), FND 1/2" IRON, N 65° E 111.65' (111.7' R) FOUND NAIL SE FACE U. POLE; S 5°E 59.05' (59.00' R.) FND MDOT TAG EAST FACE 12" MAPLE; N 40° W 42.00' (42.20' R.) SE FACE ROAD SIGN POST

B. Description of corner evidence found and/or method applied in restoring or reestablishing corner:

I-5

SEARCHED THE APPARENT LOCATION OF THE CORNER AND FOUND 1/2" REROD MENTIONED IN THE ABOVE MENTIONED LIBER AND PAGES. MONUMENT ACCEPTED AS THE BEST AVAILABLE EVIDENCE OF THE POSITION TO THE ORIGINAL CORNER.

C. Description of monument for corner and accessories established to perpetuate locating the position of the corner:

I-5

REPLACED FOUND 1/2" REROD WITH 5/8" x 24" LONG REROD WITH ARENAC CO. REMONUMENTATION CAP WITH 1/8" DRILL HOLE.
N 65° E 111.65' (111.7' R) FOUND NAIL SE FACE U. POLE
S 45° E 63.11' SET N/T SW FACE 14" POPLAR
S 5° E 59.05' (59.00' R.) FND MDOT TAG EAST FACE 12" MAPLE
S 40° W 34.91' SET NAIL AND TAG IN NW FACE 3" POPLAR
N 40° W 42.00' (42.20' R.) SE FACE ROAD SIGN POST
N 15° W 97.55' SET NAIL AND TAG IN EAST FACE 6" POPLAR

ACCEPTED BY THIS ARENAC COUNTY SURVEY PEER GROUP AS THE OFFICIAL CORNER UNDER MICHIGAN PUBLIC ACT 345 OF 1990 AT "A" MEETING HELD ON 10/30/97
Paul M. Ciosek
PAUL M. CIOSEK P.S., CHAIRMAN

STATE OF MICHIGAN
MICHAEL J. MacDONALD
PROFESSIONAL SURVEYOR
No. 22630

Signed by Michael J. MacDonald

Date 19 Dec 97

Surveyor's Michigan License No.

FIELD BOOK 2, PAGE 47

FORM APPROVED BY MICHIGAN STATE BOARD OF PROFESSIONAL SURVEYORS, JAN. 28, 1971
REVISED MAY 14, 1975
REVISED JAN., 1983
REVISED OCT., 1995