

APR 06 1999

SECTION

ARENAC COUNTY REMONUMENTATION LAND CORNER RECORDATION CERTIFICATE Filing Requirement of Act 74, Mich. P.A. 1970

For corners in

Page 1 of 1 LC 2/ 173 ROSE SMITH 1P ARENAC CO. REG. OF DEEDS RS Rec. Date 12/29/98 Time 10:51 RECORDING FEES: 9.00

ARENAC (County) Located In: Corner Code # 1-7 1. Public Land Survey T 18N R 4E 2. Property Controlling in Section S T R 3. Miscellaneous Property in Sec. S T R

Register of Deeds Stamp & File Number

4. Lot No. , Recorded Plat 5. Private Claims

Grid table with columns A-M and rows 1-13. A dot is present at row 7, column I.

I, DALE L. WINIECKE, in a field survey on AUGUST 20, 1998 do hereby state that under requirements of P.A. 74, Michigan P.A. of 1970, the corner points mentioned in lines 1 and 2 above were in conformance with regulations and rules therefore as required in the current manual of survey instructions of the United States Department of the Interior, Bureau of Land Management or by a decree of a Court of Law and /or that the corner points mentioned in lines 3, 4 and 5 above were in conformance with the rules of the Michigan Board of Land Surveyors or by a Decree of a Court of Law; established, re-established, monumented, recovered, found as expressed below:

NOTE: Not more than 2 corners, all in the same town and range, may be recorded on this certificate.

A. Description of original monument and accessories and/or subsequent restoration:


- 1. ORIGINAL POST SET IN JULY 1843 BY J. BURT, D.S. B. ASH 12" S 73° W 22 LKS. Y. BIRCH 6" N 45 1/2° E 35 LKS. 2. LCRC L.1, P.186, N. CALDWELL, PS#12018, (1964), SET 3/4" BAR FROM COUNTY SURVEYOR RECORDS 3. CERTIFICATE OF SURVEY L.1, P.395, L. MCGINNIS, PS #18999, (1979), FOUND A 3/4" BAR 4. CERTIFICATE OF SURVEY, L.1, P.660, L. MCGINNIS, PS#18999, (1989), FOUND A 3/4" BAR 5. LCRC, L.2, P.099, S. KOCH, PS#41103, (1997), FOUND A 1" BAR IN A MONUMENT BOX

B. Description of corner evidence found and/or method applied in restoring or reestablishing corner:

SEARCHED AT THE APPARENT LOCATION OF THE CORNER AND FOUND A 1" IRON BAR IN A MONUMENT BOX. CHECKED WITNESSES FROM LCRC, L.1, P.186, S56°E POWER POLE 80.83' (R) TO NAIL IN POWER POLE 80.82' (M) CHECKED WITNESSES FROM SURVEY L.1, P.395, SOUTH TO FACE OF CONCRETE ISLAND 42.3' (R&M) CHECKED WITNESSES FROM SURVEY, L.1, P.660, S56°E POWER POLE 80.83' (R) 80.82' (M) CHECKED WITNESSES FROM LCRC L.2, P.099, S60°E TO NAIL & TAG IN NORTH FACE OF P.POLE 80.74' (R) 80.82' (M); S25°E TO NAIL & TAG IN NORTH FACE OF LIGHT POLE 148.05' (R) 148.18' (M); S15°W TO BACK OF CURB 43.01' (R&M) ACCEPTED CORNER AS THE BEST AVAILABLE EVIDENCE OF THE POSITION OF THE ORIGINAL CORNER.

C. Description of monument for corner and accessories established to perpetuate locating the position of the corner:

REPLACED 1" IRON BAR WITH 5/8" X 24" LONG REBAR WITH ARENAC COUNTY REMONUMENTATION CAP IN MONUMENT BOX S 60° E 80.82' TO NAIL AND TAG IN NORTH SIDE OF POWER POLE S 20° E 148.18' TO NAIL AND TAG IN NORTH SIDE OF LIGHT POLE S 20° W 43.01' TO BACK OF CURB S 36° W 134.31' TO NORTHEAST BOLT ON EAST LEG OF HIGHWAY SIGN BASE EAST 192.00' TO SET NAIL AND TAG SOUTH SIDE OF POWER POLE S 15° W 42.65' TO CHISELED "X" IN TOP OF CURB ISLAND S 74° W 112.51' TO SET NAIL AND TAG NORTH SIDE OF POWER POLE

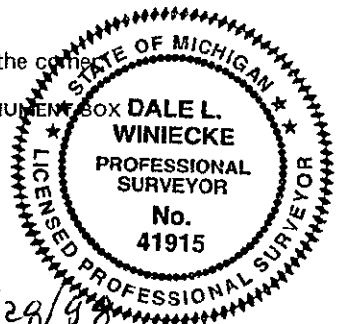

Signed by Dale Winiecke Date 12/29/98

Surveyor's Michigan License No. 41915

FB. 2, P. 76

ACCEPTED BY THIS ARENAC COUNTY SURVEY REPR GROUP AS THE OFFICIAL CORNER UNDER MICHIGAN PUBLIC ACT 245 OF 1990 AT A MEETING HELD ON 10 NOV 1998 Paul M. Ciosek, Chairman