

SURVEY & REMONUMENTATION

MAR 05 1998

SECTION

**ARENAC COUNTY REMONUMENTATION
LAND CORNER RECORDATION CERTIFICATE
Filing Requirement of Act 74, Mich. P.A. 1970**

For corners in

Arenac
(County)

Located In:

Corner Code #

Page 1 of 1
ROSE SMITH

LC 2/ 134
1P

ARENAC CO. REG. OF DEEDS
RS Rec. Date 12/23/97 Time 11:41
RECORDING FEES: 9.00

- | | | |
|------------------------------------|--------------------------|------------|
| 1. Public Land Survey | T <u>18N</u> R <u>4E</u> | <u>J-5</u> |
| | T _____ R _____ | _____ |
| | T _____ R _____ | _____ |
| | T _____ R _____ | _____ |
| 2. Property Controlling in Section | S _____ T _____ R _____ | _____ |
| | S _____ T _____ R _____ | _____ |
| 3. Miscellaneous Property in Sec. | S _____ T _____ R _____ | _____ |
| | S _____ T _____ R _____ | _____ |

4. Lot No. _____, Recorded Plat _____

5. Private Claims _____

Register of Deeds Stamp & File Number

A	B	C	D	E	F	G	H	I	J	K	L
1											
2	6		5		4		3		2		1
3											
4	7		8		9		10		11		12
5											
6	18		17		16		15		14		13
7											
8	19		20		21		22		23		24
9											
10	30		29		28		27		26		25
11											
12	31		32		33		34		35		36
13											

I, MICHAEL J. MACDONALD, in a field survey on OCTOBER 20, 1997 do hereby state that under requirements of P.A. 74, Michigan P.A. of 1970, the corner points mentioned in lines 1 and 2 above were in conformance with regulations and rules therefore as required in the current manual of survey instructions of the United States Department of the Interior, Bureau of Land Management or by a decree of a Court of Law and /or that the corner points mentioned in lines 3, 4 and 5 above were in conformance with the rules of the Michigan Board of Land Surveyors or by a Decree of a Court of Law; established, re-established, monumented, recovered, found as expressed below:

NOTE: Not more than 2 corners, all in the same town and range, may be recorded on this certificate.

A. Description of original monument and accessories and/or subsequent restoration:

- J-5
1. ORIGINAL POST SET JULY 1837, J. BURT D.S.
CEDAR 9° S 87° W 14 LKS.
CEDAR 6° N 46° E 12 LKS.
 2. COUNTY SURVEYOR NOTES 1915, FOUND POST
 3. SURVEY, L. 1, P. 570, BURGIN (1986) SET T IRON WITH CAP PS #29240
S 86° W 257.0' NAIL IN SOUTH SIDE TWIN COTTONWOOD
N 59° E 197.5' NAIL IN 12" COTTONWOOD
S 71° E 55.74 CENTERLINE WOOD FENCE POST
SOUTH 26' TO EDGE OF FARM FIELD EAST-WEST
 4. MDOT WITNESS CARD, S. KOCH
RESET T IRON 1.5' BELOW GRADE. PLACED STEEL FENCE POST BESIDE.
S 86° W 257.0' NAIL IN SOUTH SIDE TWIN COTTONWOOD
N 59° E 197.5' NAIL IN 12" COTTONWOOD
NO OTHER WITNESSES NEAR

ACCEPTED BY THIS ARENAC COUNTY SURVEY FEE GROUP AS THE OFFICIAL CORNER UNDER MICHIGAN PUBLIC ACT 345 OF 1990 AT A MEETING HELD ON 10/20/97
Paul M. Ciosek
PAUL M. CIOSEK P.S., CHAIRMAN


B. Description of corner evidence found and/or method applied in restoring or reestablishing corner:

J-5
SEARCHED THE APPARENT LOCATION OF THE CORNER AND FOUND THE T- IRON SET BY BURGIN IN SURVEY, L. 1, P. 570, THE T-IRON WAS 1.5' BELOW GRADE NEXT TO STEEL FENCE POST. ACCEPTED THE T-IRON AS THE BEST AVAILABLE EVIDENCE OF THE POSITION OF THE ORIGINAL CORNER.

C. Description of monument for corner and accessories established to perpetuate locating the position of the corner:

J-5
DROVE DOWN T-IRON WITH 5/8" x 24" LONG REROD WITH ARENAC CO. REMONUMENTATION CAP WITH 1/8" DRILL HOLE.
S 86° W 257.0' NAIL IN SOUTH SIDE TWIN COTTONWOOD
N 59° E 197.5' NAIL IN 12" COTTONWOOD N 43° E NAIL AND TAG IN WEST SIDE OF 14' POPLAR 75.38' (74.91' R.)
S. 92.50' NAIL AND TAG IN WEST SIDE OF 3" POPLAR
N 45° W 50.00' SET CAPPED 3/8" REROD
N 45° E 50.00' SET CAPPED 3/8" REROD

Signed by Michael J. MacDonald
Surveyor's Michigan License No. 22438

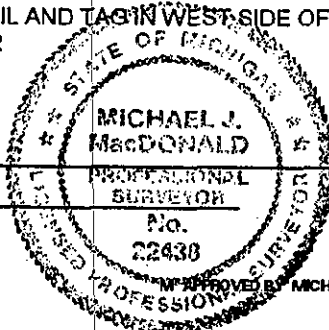

Date 19 Dec 97

FIELD BOOK 2, PAGE 48