

APR 06 1999

SECTION

ARENAC COUNTY REMONUMENTATION LAND CORNER RECORDATION CERTIFICATE Filing Requirement of Act 74, Mich. P.A. 1970

For corners in

ARENAC (County)

Located In:

Corner Code

Page 1 of 1 ROSE SMITH

LC 2/ 176 1P

ARENAC CO. REG. OF DEEDS

RS Rec. Date 12/29/98

Time 10:51

RECORDING FEES:

9.00

- 1. Public Land Survey T 18N R 4E J-7
2. Property Controlling in Section S T R
3. Miscellaneous Property in Sec. S T R

Register of Deeds Stamp & File Number

4. Lot No. , Recorded Plat
5. Private Claims

I, DALE L. WINIECKE, in a field survey on JULY 30, 1998 do hereby state that under requirements of P.A. 74, Michigan P.A. of 1970, the corner points mentioned in lines 1 and 2 above were in conformance with regulations and rules therefore as required in the current manual of survey instructions of the United States Department of the Interior, Bureau of Land Management or by a decree of a Court of Law and /or that the corner points mentioned in lines 3, 4 and 5 above were in conformance with the rules of the Michigan Board of Land Surveyors or by a Decree of a Court of Law; established, re-established, monumented, recovered, found as expressed below:

NOTE: Not more than 4 corners, all in the same town and range, may be recorded on this certificate.

Grid table with columns A-M and rows 1-13. A dot is marked at the intersection of column J and row 7.

A. Description of original monument and accessories and/or subsequent restoration:


- 1. ORIGINAL POST SET IN JULY 1843, J. BURT, D.S. Y. BIRCH 10" N 80 1/2° W 14 LKS. Y. BIRCH 13" S 66 1/2° E 20 LKS.
2. LCRC L.1, P.179, N. CALDWELL, PS # 12018, (1964), SET STEEL FENCE POST AND 1/2" PIPE
3. CERTIFICATE OF SURVEY, L.1, P.660, L. MCGINNIS, PS # 18999, (1989), FOUND 1/2" PIPE
4. LCRC L.2, P.102, S. KOCH, PS#41103, (1997), FOUND 1/2" PIPE

B. Description of corner evidence found and/or method applied in restoring or reestablishing corner:

J-7 SEARCHED AT THE APPARENT LOCATION OF THE CORNER AND FOUND A 1/2" PIPE WITH FENCE POST BROKEN OFF. EXCAVATED POINT AND FOUND NO OTHER OBJECTS. CHECKED WITNESSES FROM L.2, P.102. N35°W TO NAIL & TAG IN WEST FACE OF FENCE POST 40.57'(R) 40.51'(M); SOUTH TO NAIL & TAG IN EAST FACE OF FENCE POST 28.47'(R) 28.48'(M); S62°W TO NAIL & TAG IN WEST FACE 18" WALNUT 59.13'(R) 59.15'(M). ACCEPTED 1/2" PIPE AS THE BEST AVAILABLE EVIDENCE OF THE POSITION OF THE ORIGINAL CORNER.

C. Description of monument for corner and accessories established to perpetuate locating the position of the corner:

J-7 REPLACED 1/2" PIPE WITH 5/8" X 24" LONG REBAR WITH ARENAC COUNTY REMONUMENTATION CAP NORTH 5.5' TO THE PHYSICAL CENTERLINE OF SAGATOO ROAD SOUTH 28.48' TO NAIL AND TAG IN EAST SIDE OF RAILROAD TIE FENCE POST N 30°E 163.12' TO SOUTHEAST CORNER OF METAL BUILDING N 35° W 40.51' TO NAIL AND TAG IN EAST SIDE OF RAILROAD TIE FENCE POST S 62° W 59.15' TO NAIL AND TAG IN NW SIDE OF 18" WALNUT N 35° W 41.12' TO NAIL AND TAG #9433 IN THE NORTHEAST CORNER OF RAILROAD TIE FENCE POST

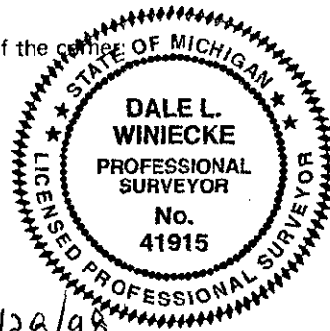

Signed by Dale Winiecke

Date 12/28/98

Surveyor's Michigan License No. 41915

FB. 2, P. 72

ACCEPTED BY THIS ARENAC COUNTY SURVEY PEER GROUP AS THE OFFICIAL CORNER UNDER MICHIGAN PUBLIC ACT 345 OF 1990 AT A MEETING HELD ON 10 Nov 1998. Kent M. Crossed PS, CHAIRMAN