

**SURVEY & REMONUMENTATION**

MAR 05 1998

**ARENAC COUNTY REMONUMENTATION  
LAND CORNER RECORDATION CERTIFICATE  
Filing Requirement of Act 74, Mich. P.A. 1970**

**SECTION**

For corners in

<u>Arenac</u> (County)	Located In:	Corner Code #
1. Public Land Survey	<u>T18N R4E</u>	<u>K-4</u>
	T <u>    </u> R <u>    </u>	<u>    </u>
	T <u>    </u> R <u>    </u>	<u>    </u>
	T <u>    </u> R <u>    </u>	<u>    </u>
2. Property Controlling in Section	S <u>    </u> T <u>    </u> R <u>    </u>	<u>    </u>
	S <u>    </u> T <u>    </u> R <u>    </u>	<u>    </u>
3. Miscellaneous Property in Sec.	S <u>    </u> T <u>    </u> R <u>    </u>	<u>    </u>
	S <u>    </u> T <u>    </u> R <u>    </u>	<u>    </u>
4. Lot No. <u>    </u> , Recorded Plat <u>    </u>		
5. Private Claims <u>    </u>		

Page 1 of 1  
ROSE SMITH  
ARENAC CO. REG. OF DEEDS  
RS Rec. Date 12/23/97 Time 11:45  
RECORDING FEES: 9.00  
LC 2/ 142  
1P

Register of Deeds Stamp & File Number

A	B	C	D	E	F	G	H	I	J	K	L	P
1												
2	6		5		4		3		2		1	
3												
4	7		8		9		10		11		12	
5												
6	18		17		16		15		14		13	
7												
8	19		20		21		22		23		24	
9												
10	30		29		28		27		26		25	
11												
12	31		32		33		34		35		36	
13												

I, MICHAEL J. MACDONALD, in a field survey on SEPTEMBER 15, 1997 do hereby state that under requirements of P.A. 74, Michigan P.A. of 1970, the corner points mentioned in lines 1 and 2 above were in conformance with regulations and rules therefore as required in the current manual of survey instructions of the United States Department of the Interior, Bureau of Land Management or by a decree of a Court of Law and for that the corner points mentioned in lines 3, 4 and 5 above were in conformance with the rules of the Michigan Board of Land Surveyors or by a Decree of a Court of Law; established, re-established, monumented, recovered, found as expressed below:

NOTE: Not more than 2 corners, all in the same town and range, may be recorded on this certificate.

A. Description of original monument and accessories and/or subsequent restoration:

K-4

1. ORIGINAL POST SET ON JULY 1837 J. BURT D.S.  
CEDAR 9" S 87° W 14 LKS.  
CEDAR 6" N 46° E 12 LKS.
2. SURVEY, L. 1, P. 515, MCGINNIS, FND 3/4" PIPE:  
SOUTH 33.3' TO 5" BIRCH TREE  
EAST 29.55' TO EAST FACE TELEPHONE PEDESTAL  
NE 92.15' TO FACE 20" TAMARACK
3. SURVEY, L. 1, P. 559, MCGINNIS, (6/26/87):  
N 30° E 75.9' TO TAG IN 12" CEDAR  
N 60° E 37.8' TO TELEPHONE POLE  
S 40° E 85.0' TO 18" ELM
4. LCRC, L. 1, P. 1335, MILLER, (9/23/93)  
FOUND A 3/4" PIPE ON CENTERLINE OF ROAD  
EAST 29.80' TELEPHONE TRANSFORMER  
N 48° E 75.40' 12" POPLAR  
N 45° W 46.00' 8" CEDAR  
S 50° W 47.58" 12" ASH
5. LCRC, L. 2, P. 105, KOCH, (1997) FOUND 3/4" PIPE:  
N 45° E NAIL AND TAG IN WEST SIDE 14" POPLAR 74.91'  
S 86° E NAIL AND TAG IN SOUTH SIDE OF  
POWER POLE 174.34'  
S 45° W NAIL IN WEST SIDE OF 13" ELM 47.59'  
N 41° W NAIL IN SOUTH SIDE 8" CEDAR 45.98'

B. Description of corner evidence found and/or method applied in restoring or reestablishing corner:

K-4


SEARCHED THE LOCATION OF THE CORNER AND FOUND A 3/4" PIPE. EXCAVATED THE AREA AND FOUND THE PIPE TO BE 29 1/2" LONG. FOUND NO OTHER OBJECTS IN THE AREA. 3/4" PIPE ACCEPTED AS THE BEST AVAILABLE EVIDENCE OF THE POSITION OF THE ORIGINAL CORNER.

C. Description of monument for corner and accessories established to perpetuate locating the position of the corner:

K-4

REPLACED THE FOUND 3/4" PIPE WITH A 5/8" X 24" REROD WITH ARENAC CO. REMONUMENTATION CAP WITH 1/8" DRILL HOLE.  
N 43° E 75.38' (74.91' R.) NAIL AND TAG IN WEST SIDE 14" POPLAR  
S 86° E 174.95' (174.34' R.) NAIL AND TAG IN SOUTH SIDE OF POWER POLE  
S 45° W 47.65' (47.59' R.) NAIL IN WEST SIDE OF 13" ELM  
N 41° W 45.95' (45.98' R.) NAIL IN SOUTH SIDE 8" CEDAR  
S 15° E 160.90' SET NAIL AND TAG IN NE FACE 14" MAPLE

Signed by Michael J. MacDonald  
Surveyor's Michigan License No. 22438

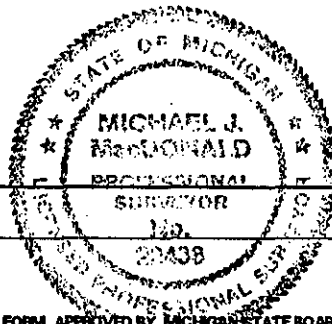

Date 12 Dec 97

FIELD BOOK 2, PAGE 40

ACCEPTED BY THIS ARENAC COUNTY SURVEY PEER GROUP AS THE OFFICIAL CORNER UNDER MICHIGAN PUBLIC ACT 345 OF 1990 AT A MEETING HELD ON 10/30/97  
Paul M. Ciccho  
PAUL M. CICCHO, P.E. CHAIRMAN

FORM APPROVED BY MICHIGAN STATE BOARD OF PROFESSIONAL SURVEYORS, JAN. 28, 1971  
REVISED MAY 14, 1976  
REVISED JAN., 1983  
REVISED OCT., 1995