

SURVEY & REMONUMENTATION

MAR 05 1998

**ARENAC COUNTY REMONUMENTATION
LAND CORNER RECORDATION CERTIFICATE**
Filing Requirement of Act 74, Mich. P.A. 1970

For corners in

Page 1 of 1
ROSE SMITH

LC 2 / 132
1P

ARENAC CO. REG. OF DEEDS
MS Rec. Date 12/23/97 Time 11:40
RECORDING FEES: 9.00

Arenac
(County)

Located In:

Corner Code

1. Public Land Survey T18N R4E K-6
 T R
 T R
 T R
 T R
2. Property Controlling in Section S T R
 S T R
3. Miscellaneous Property in Sec. S T R
 S T R
4. Lot No. , Recorded Plat
5. Private Claims

Register of Deeds Stamp & File Number

	A	B	C	D	E	F	G	H	I	J	K	L	M
1													
2	6		5		4		3		2		1		
3													
4	7		8		9		10		11		12		
5													
6	18		17		16		15		14		13		
7													
8	19		20		21		22		23		24		
9													
10	30		29		28		27		26		25		
11													
12	31		32		33		34		35		36		
13													


I, MICHAEL J. MACDONALD, in a field survey on SEPTEMBER 12, 1997 do hereby state that under requirements of P.A. 74, Michigan P.A. of 1970, the corner points mentioned in lines 1 and 2 above were in conformance with regulations and rules therefore as required in the current manual of survey instructions of the United States Department of the Interior, Bureau of Land Management or by a decree of a Court of Law and /or that the corner points mentioned in lines 3, 4 and 5 above were in conformance with the rules of the Michigan Board of Land Surveyors or by a Decree of a Court of Law; established, re-established, monumented, recovered, found as expressed below:

NOTE: Not more than 2 corners, all in the same town and range, may be recorded on this certificate.

A. Description of original monument and accessories and/or subsequent restoration:

K-6

- ORIGINAL POST SET ON JULY 1843, J. BURT D.S.
HEMLOCK 18° S 87°W 18 LKS.
HEMLOCK 9° N 65°E 32 LKS.
- COUNTY SURVEYOR NOTES, FOUND CORNER OCTOBER 1915
- SURVEY, L. 1, P.665, MCGINNIS, 1990
FOUND 3/8" IRON (BENT) RESET
WEST 32.8' TO CONC. MON.
SSW 88.8' TO MDOT TAG ON EAST SIDE OF UTILITY POLE
SW 113.55 TO SE FOUNDATION CORNER
SE 81.61' TO CAPPED NAIL IN WEST SIDE OF 20"ASH
S 71°30' E 8.34' TO 1/2" IRON
- SURVEY, L. 1, P. 669, MCGINNIS, 1989
SURVEY, L. 1, P. 660, MCGINNIS, 1989
SURVEY, L. 1, P. 326, MCGINNIS, 1977
SURVEY, L. 1, P. 65, MCGINNIS, 1973
FOUND IRON
SW 104.5 TO NE FOUNDATION
SSW 89.0' TO POWER POLE
- LCRC, L 2, P. 107, KOCH, 1995, FOUND CAPPED 3/8" REROD
WEST 32.68' TO CONCRETE MONUMENT
S 71° E 8.34' TO FOUND 1/2" IRON
S 20° W 88.69' MDOT NAIL/TAG IN E FACE POWER POLE
S 50° W 113.25' SE CORNER HOUSE #3509 FOUNDATION
S 85° W 94.50' NE CORNER HOUSE #3509 FOUNDATION

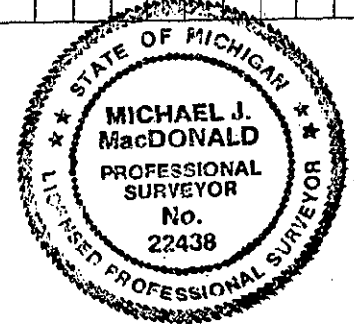

B. Description of corner evidence found and/or method applied in restoring or reestablishing corner:

K-6

SEARCHED THE APPARENT LOCATION OF THE CORNER AND FOUND A CAPPED 3/8" REROD (CAP OBLITERATED) WITH A BENT 3/8" REROD ALONG SIDE AND A 1/2" REROD 8.34' EASTERLY FROM THE CAPPED 3/8" REROD AS CALLED FOR IN SURVEY L. 1, P 665. THERE IS NO RECORDED INFORMATION USING THE 1/2" REROD AS K-6. ACCEPTED THE CAPPED 3/8" IRON AS THE BEST AVAILABLE EVIDENCE OF THE LOCATION OF THE ORIGINAL CORNER.

C. Description of monument for corner and accessories established to perpetuate locating the position of the corner:

K-6

REPLACED THE CAPPED 3/8" REROD WITH A 5/8" x 24" REROD WITH ARENAC CO. REMONUMENTATION CAP WITH 1/8" DRILL HOLE.
 WEST 32.70' (32.68' R.) TO CONCRETE MONUMENT
 N 80° E 40.50' SET N/T IN N FACE 15" APPLE TREE
 S 71° E 8.43' (8.34' R.) TO FOUND 1/2" IRON
 S 20° W 88.78' (88.69' R.) MDOT NAIL/TAG IN E FACE POWER POLE
 S 50° W 113.30' (113.25' R.) SE CORNER HOUSE #3509 FOUNDATION
 S 85° W 94.50' (94.50' R.) NE CORNER HOUSE #3509 FOUNDATION
 ±5.5' W OF PHYSICAL CENTERLINE OF EAST CITY LIMITS ROAD

ACCEPTED BY THIS ARENAC COUNTY SURVEY PEER GROUP AS THE OFFICIAL CORNER UNDER MICHIGAN PUBLIC ACT 345 OF 1990 AT 'A' MEETING HELD ON 10/30/97
Paul M. Curado
 PAUL M. GOSDEP'S, CHAIRMAN

Signed by Michael J. MacDonald

Date 22 Dec 97

Surveyor's Michigan License No. 22438

FIELD BOOK 2, PAGE 42