

SURVEY & REMONUMENTATION

MAR 05 1998

SECTION

ARENAC COUNTY REMONUMENTATION LAND CORNER RECORDATION CERTIFICATE Filing Requirement of Act 74, Mich. P.A. 1970

For corners in

ARENAC (County)

Located in:

Corner Code

Page 1 of 1

ROSE SMITH

LC 2/ 140

1P

ARENAC CO. REG. OF DEEDS

RS Rec. Date 12/23/97 Time 11:44

RECORDING FEES: 9.00

- 1. Public Land Survey T18N R.4E K-10
2. Property Controlling in Section S T R
3. Miscellaneous Property in Sec. S T R

Register of Deeds Stamp & File Number

4. Lot No. , Recorded Plat

5. Private Claims


I, MICHAEL J. MACDONALD, in a field survey on OCTOBER 23, 1997 do hereby state that under requirements of P.A. 74, Michigan P.A. of 1970, the corner points mentioned in lines 1 and 2 above were in conformance with regulations and rules therefore as required in the current manual of survey instructions of the United States Department of the Interior, Bureau of Land Management or by a decree of a Court of Law and for that the corner points mentioned in lines 3, 4 and 5 above were in conformance with the rules of the Michigan Board of Land Surveyors or by a Decree of a Court of Law; established, re-established, monumented, recovered, found as expressed below:

NOTE: Not more than 2 corners, all in the same town and range, may be recorded on this certificate.

A. Description of original monument and accessories and/or subsequent restoration:

K-10

- 1. ORIGINAL POST SET BY J. BURT 1843 HEMLOCK 11" S 43° W 7 LINKS HEMLOCK 10" N 61° E 13 LINKS
2. COUNTY SURVEYOR NOTES, 1915 FOUND IRON BOLT, 2 WHITE BRICKS, A BOTTLE, BROKEN GLASS AND CROCKERY.
3. SURVEY, L. 2, P. 155, MCGINNIS, 1995, FND 5/8" BAR S 45°W 58.54 FND PK IN UP WEST 30.52' MAG NAIL IN N. FACE TWIN 28" CEDAR NORTH 20.77' FND PK IN CORNER POST EAST 38.7 MAG NAIL IN CORNER POST

B. Description of corner evidence found and/or method applied in restoring or reestablishing corner:


K-10

SEARCHED THE APPARENT LOCATION OF THE CORNER AND FOUND 6" BELOW THE SURFACE OF THE ROAD A LARGE ROCK ABOVE 5/8" BAR PER WITNESSES, L. 2, P. 155. DUG FURTHER AND FOUND A BURIED CABLE 36" BELOW SURFACE. ACCEPTED THE 5/8" BAR AS THE BEST AVAILABLE EVIDENCE OF THE POSITION OF THE ORIGINAL CORNER.

C. Description of monument for corner and accessories established to perpetuate locating the position of the corner:

K-10

SET ON TOP OF FND 5/8" BAR AN ARENAC CO. REMONUMENTATION CAP WITH 1/8" DRILL HOLE. S 45°W 58.65' (58.54 R.) FND MAG NAIL E. FACE UP S 80° W 30.60' (30.52' R.) FND MAG NAIL IN N. FACE TWIN 28" CEDAR NORTH 20.99' (20.77' R.) FND PK W. FCE CORNER POST, FENCE RUNNING NORTH EAST 38.74' (38.7' R.) MAG NAIL IN CORNER POST, FENCE RUNNING EAST N 40°E 20.44 SET MAG NAIL IN SE FACE WHITE PINE

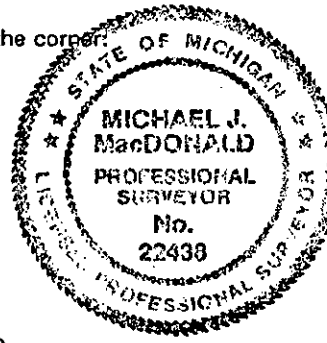

Signed by Michael J. MacDonald Surveyor's Michigan License No. 22438

Date 12 Dec 97

FIELD BOOK 2, PAGE 64

ACCEPTED BY THIS ARENAC COUNTY SURVEY PEER GROUP AS THE OFFICIAL CORNER UNDER MICHIGAN PUBLIC ACT 845 OF 1990 AT A MEETING HELD ON 10/30/97 Paul M. Ciolek

MICHIGAN STATE BOARD OF PROFESSIONAL SURVEYORS, JAN. 28, 1971 REVISED MAY 14, 1976 REVISED JAN., 1983 REVISED OCT., 1985