

APR 06 1999

SECTION

ARENAC COUNTY REMONUMENTATION
LAND CORNER RECORDATION CERTIFICATE
Filing Requirement of Act 74, Mich. P.A. 1970

For corners in

<u>ARENAC</u> (County)	Located In:	Corner Code #
1. Public Land Survey	T <u>18N</u> R <u>4E</u>	<u>L-7</u>
	T _____ R _____	_____
	T _____ R _____	_____
	T _____ R _____	_____
2. Property Controlling in Section	S _____ T _____ R _____	_____
	S _____ T _____ R _____	_____
3. Miscellaneous Property in Sec.	S _____ T _____ R _____	_____
	S _____ T _____ R _____	_____

Page 1 of 1
ROSE SMITH
ARENAC CO. REG. OF DEEDS
Date 12/29/98 Time 10:51
RECORDING FEES: 9.00
LC 2/ 175
1P

Register of Deeds Stamp & File Number

4. Lot No. _____, Recorded Plat _____
5. Private Claims _____

I, Dale L. Winiecke, in a field survey on AUGUST 3, 1998 do hereby state that under requirements of P.A. 74, Michigan P.A. of 1970, the corner points mentioned in lines 1 and 2 above were in conformance with regulations and rules therefore as required in the current manual of survey instructions of the United States Department of the Interior, Bureau of Land Management or by a decree of a Court of Law and for that the corner points mentioned in lines 3, 4 and 5 above were in conformance with the rules of the Michigan Board of Land Surveyors or by a Decree of a Court of Law; established, re-established, monumented, recovered, found as expressed below:

	A	B	C	D	E	F	G	H	I	J	K	L	M
1													
2	6		5		4		3		2		1		
3													
4	7		8		9		10		11		12		
5													
6	18		17		16		15		14		13		
7													
8	19		20		21		22		23		24		
9													
10	30		29		28		27		26		25		
11													
12	31		32		33		34		35		36		
13													

NOTE: Not more than 4 corners, all in the same town and range, may be recorded on this certificate.

A. Description of original monument and accessories and/or subsequent restoration:
L-7


1. ORIGINAL POST SET IN JULY 1843 BY J. BURT, D.S.
HEMLOCK 6" N 21° E 15 LKS.
HEMLOCK 8" S 16 1/2° W 33 LKS.
2. CERTIFICATE OF SURVEY, L.1, P.19-20, L. MCGINNIS, PS#18999, (1972), IRON
3. LCRC, L.1, P.111, L. MCGINNIS, PS#18999, (1977), FOUND IRON
4. LCRC, L.2, P.111, S. KOCH, PS#41103, (1997), FOUND 3/8" IRON

B. Description of corner evidence found and/or method applied in restoring or reestablishing corner:
L-7

SEARCHED AT THE APPARENT LOCATION OF THE CORNER AND FOUND A 3/8" IRON. CHECKED WITNESSES FROM LCRC L.2, P.111 S 45° W TO TOP OF TELEPHONE PEDESTAL 57.86'(R) 57.94(M)'; N5°E TO NAIL IN THE WEST FACE OF P. POLE 28.80' (R) 28.76' (M); ACCEPTED CORNER AS THE BEST AVAILABLE EVIDENCE OF THE POSITION OF THE ORIGINAL CORNER.

C. Description of monument for corner and accessories established to perpetuate locating the position of the corner:
L-7

REPLACED 3/8" IRON WITH 5/8" X 24" LONG REBAR WITH ARENAC COUNTY REMONUMENTATION CAP NORTH 32.20' TO SET NAIL & TAG IN WEST FACE OF FENCE POST N 64° W 133.58' TO SET NAIL & TAG IN NORTH FACE OF 8" CHERRY TREE S 46° W 110.17' TO SET NAIL & TAG IN EAST FACE OF 16" ELM EAST 1.0' TO PHYSICAL CENTERLINE OF NORTH ROAD NORTH 32.98' TO 3/8" REBAR W/ CAP PS#13030

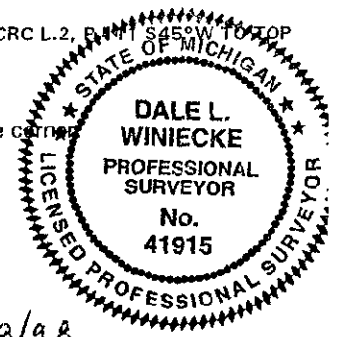

Signed by Dale Winiecke

Date 12/28/98

Surveyor's Michigan License No. _____
FB. 2, P. 73

ACCEPTED BY THIS ARENAC COUNTY SURVEY PEER GROUP AS THE OFFICIAL CORNER UNDER MICHIGAN PUBLIC ACT 345 OF 1990 AT A MEETING HELD ON 10 NOV 1998
Paul M. Ciosek
PAUL M. CIOSEK P.S., CHAIRMAN