SURVEY & REMONUMENTATION

APR 06 1999

SECTION

ARENAC COUNTY REMONUMENTATION
LAND CORNER RECORDATION CERTIFICATE
Filing Requirement of Act 74, Mich. P.A. 1970

For corners in

ARENAC
(County)

Located In:

Corner Code

Page 1 of 1 LC 2/ 165
ROSE SMITH IP
ARENAC CO. REG. OF DEEDS
RS Rec. Date 12/29/98 Time 10:51
RECORDING FEES: 9.00

1. Public Land Survey		T 18N R 4E	M-7
		T 18N R 5E	A-7
		T___ R___	
		T___ R___	
2. Property Controlling	S___	T___ R___	
in Section	S___	T___ R___	
3. Miscellaneous	S___	T___ R___	
Property in Sec.	S___	T___ R___	

Register of Deeds Stamp & File Number

4. Lot No. _____ , Recorded Plat _____

5. Private Claims _____

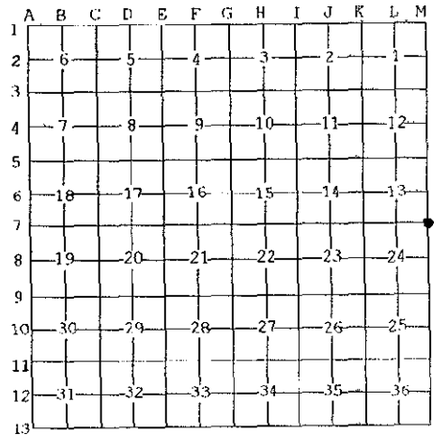

I, DALE L. WINIECKE, in a field survey on AUGUST 20, 19 98 do hereby state that under requirements of P.A. 74, Michigan P.A. of 1970, the corner points mentioned in lines 1 and 2 above were in conformance with regulations and rules therefore as required in the current manual of survey instructions of the United States Department of the Interior, Bureau of Land Management or by a decree of a Court of Law and /or that the corner points mentioned in lines 3, 4 and 5 above were in conformance with the rules of the Michigan Board of Land Surveyors or by a Decree of a Court of Law; established, re-established, monumented, recovered, found as expressed below:

NOTE: Not more than 2 corners, all in the same town and range, may be recorded on this certificate.

A. Description of original monument and accessories and/or subsequent restoration:

M-7
1. ORIGINAL POST SET IN 1837 BY L. CLASON, D.S.

G. BIRCH 8" N81°W 24 LINKS
B. ASH 14" N22°E 12 LINKS

2. CERTIFICATE OF SURVEY, L.1, P.4, G. DeLaMATER, PS#13030, (1971), FOUND IRON

3. CERTIFICATE OF SURVEY, L.1, P.20-21 L. McGINNIS, PS#18999, (1972), IRON

4. LCRC - L. 1, P. 111, L. McGINNIS, PS #18999, (1977), 3/8" ROD

5. PARTIAL SURVEY P.CIOSEK, PS#25835, (1989), FOUND IRON

B. Description of corner evidence found and/or method applied in restoring or reestablishing corner:

M-7
SEARCHED APPARENT LOCATION AND FOUND 3/8" REBAR. EXCAVATED CORNER AND FOUND NO OTHER OBJECTS.
CHECKED WITNESSES FROM L.1, P.111; NORTHWEST TO FENCE CORNER 39.75' (R) 42.70' (M) NOTE: FENCE CORNER LEANING BADLY.

3/8" REBAR ACCEPTED AS THE BEST AVAILABLE EVIDENCE OF THE POSITION OF THE ORIGINAL CORNER

C. Description of monument for corner and accessories established to perpetuate locating the position of the corner:

M-7
REPLACED 3/8" REBAR WITH 5/8" X 24" LONG REBAR WITH ARENAC COUNTY REMONUMENTATION CAP

N38°W 80.52' TO MDOT NAIL AND TAG IN SOUTHWEST FACE OF POWER POLE
N46°W 30.02' TO CHISELED 'X' IN TOP OF WEST END OF 36" CMP
N80°E 91.19' TO NAIL & TAG IN SOUTHWEST FACE OF 4" ELM
S32°E 38.47' TO NAIL & TAG IN NORTHEAST CORNER OF SIGN POST
S64°W 51.23' TO NAIL & TAG #9433 IN SOUTHEAST CORNER OF SQUARE BELL BOX GUARD POST

STATE OF MICHIGAN
DALE L. WINIECKE
PROFESSIONAL SURVEYOR
No. 41915
LICENSED PROFESSIONAL SURVEYOR

Signed by Dale Winiecke Date 12/28/98

Surveyor's Michigan License No. 41915

FB. 2, P. 74

FORM APPROVED BY MICHIGAN STATE BOARD OF PROFESSIONAL SURVEYORS, JAN. 28, 197
REVISED MAY 14,197
REVISED JAN., 198
REVISED OCT., 199

ACCEPTED BY THIS ARENAC COUNTY SURVEY PEER GROUP AS THE OFFICIAL CORNER UNDER MICHIGAN PUBLIC ACT 345 OF 1990 AT "A" MEETING HELD ON 10 NOV 1998
Paul M. Ciosek
PAUL M. CIOSEK P.S., CHAIRMAN