

SURVEY & REMONUMENTATION

MAR 05 1998

SECTION

**ARENAC COUNTY REMONUMENTATION
LAND CORNER RECORDATION CERTIFICATE
Filing Requirement of Act 74, Mich. P.A. 1970**

For corners in

Page 1 of 1
ROSE SMITH

LC 2/ 137
1P

ARENAC CO. REG. OF DEEDS
RS Rec. Date 12/23/97 Time 11:42
RECORDING FEES: 9.00

ARENAC
(County)

Located In:

Corner Code #

- | | | |
|------------------------------------|----------------|-------------|
| 1. Public Land Survey | T18N R4E | <u>M-10</u> |
| | T18N R5E | A-10 |
| | T___ R___ | _____ |
| | T___ R___ | _____ |
| 2. Property Controlling in Section | S___ T___ R___ | _____ |
| | S___ T___ R___ | _____ |
| 3. Miscellaneous Property in Sec. | S___ T___ R___ | _____ |
| | S___ T___ R___ | _____ |

Register of Deeds Stamp & File Number

4. Lot No. _____, Recorded Plat _____

5. Private Claims _____

I, MICHAEL J. MACDONALD, in a field survey on OCTOBER 23, 1997 do hereby state that under requirements of P.A. 74, Michigan P.A. of 1970, the corner points mentioned in lines 1 and 2 above were in conformance with regulations and rules therefore as required in the current manual of survey instructions of the United States Department of the Interior, Bureau of Land Management or by a decree of a Court of Law and /or that the corner points mentioned in lines 3, 4 and 5 above were in conformance with the rules of the Michigan Board of Land Surveyors or by a Decree of a Court of Law; established, re-established, monumented, recovered, found as expressed below:

	A	B	C	D	E	F	G	H	I	J	K	L	M
1													
2	6		5		4		3		2		1		
3													
4	7		8		9		10		11		12		
5													
6	18		17		16		15		14		13		
7													
8	19		20		21		22		23		24		
9													
10	30		29		28		27		26		25		
11													
12	31		32		33		34		35		36		
13													

NOTE: Not more than 2 corners, all in the same town and range, may be recorded on this certificate.

A. Description of original monument and accessories and/or subsequent restoration:

M-10

- ORIGINAL POST SET BY L. CLASON D.S. 1837
HEMLOCK 20" N 63 1/2"E 19 LINKS
HICKORY 20" N 10"W 45 LINKS
- EDMANDS ENG. WITNESS SHEET, 1968, FOUND 3/4" PIPE
- SPICER ENGINEERING NOTES, 1968 FOUND 1" PIPE PAINTED RED AT INTERSECTION OF FENCES
- UNRECORDED SURVEY, JOHN MEYERS (#14099), SEPTEMBER 1995, SET W 1/4 CORNER SECTION 30, T18N, R5E, SET CAPPED 1/2" REROD
CORNER IS COMMON WITH A-10, T18N, R5E

B. Description of corner evidence found and/or method applied in restoring or reestablishing corner:

M-10



SEARCHED THE APPARENT LOCATION OF THE CORNER AND FOUND A 1" PIPE PAINTED RED AT THE INTERSECTION OF A FENCE RUNNING TO THE NORTH AND EAST. FOUND A 1/2" CAPPED REROD SET BY JOHN MEYERS 1' EAST AND 8.8' NORTH OF THE FOUND 3/4" PIPE AT THE FENCE CORNER. THE 1" PIPE WAS ACCEPTED AS THE BEST AVAILABLE EVIDENCE OF THE POSITION OF THE ORIGINAL CORNER.

C. Description of monument for corner and accessories established to perpetuate locating the position of the corner:

M-10

SET A 5/8" x 36" REROD IN THE CENTER OF THE 1 1/4" PIPE AND DROVE THE PIPE BENEATH THE GROUND AND PLACED AN ARENAC COUNTY REMONUMENTATION CAP WITH 1/8" DRILL HOLE ON THE REROD.
N 50° W 9.38' FND NAIL IN SOUTH SIDE 3" ELM
N 5° E 10.20' FOUND CAPPED 1/2" REROD PS#14099
N 15° E 17.24' FND NAIL WEST FACE 8" HICKORY
N 45° E 37.25' FND NAIL IN SOUTH FACE 10" POPLAR
N 70° E 13.13' FND NAIL IN NORTH FACE 12" POPLAR

Signed by Michael J. MacDonald
Surveyor's Michigan License No. 22438

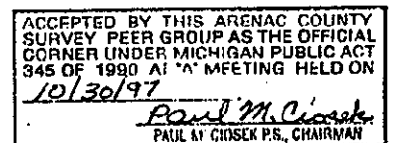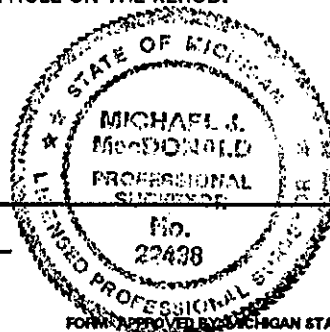

Date 18 Dec 97

FIELD BOOK 2, PAGE 56