

**ARENAC COUNTY REMONUMENTATION
LAND CORNER RECORDATION CERTIFICATE
Filing Requirement of Act 74, Mich. P.A. 1970**

RECORDED
JAN 25 2000

For corners in

<u>ARENAC COUNTY</u> (County)	Located In:	Corner Code #
1. Public Land Survey	T <u>18N</u> R <u>5E</u>	<u>B-7</u>
	T ___ R ___	___
	T ___ R ___	___
	T ___ R ___	___
2. Property Controlling in Section	S ___ T ___ R ___	___
	S ___ T ___ R ___	___
3. Miscellaneous Property in Sec.	S ___ T ___ R ___	___
	S ___ T ___ R ___	___

SECTION

Page 1 of 1
ROSE SMITH
ARENAC CO. REG. OF DEEDS
RS Date 01/06/2000 Time 10:07:46
RECORDING FEES: 9.00
LC 2/203
1P

Register of Deeds Stamp & File Number

4. Lot No. _____, Recorded Plat _____

5. Private Claims _____

I, DALE L. WINIECKE, in a field survey on JULY, 1999 do hereby state that under requirements of P.A. 74, Michigan P.A. of 1970, the corner points mentioned in lines 1 and 2 above were in conformance with regulations and rules therefore as required in the current manual of survey instructions of the United States Department of the Interior, Bureau of Land Management or by a decree of a Court of Law and /or that the corner points mentioned in lines 3, 4 and 5 above were in conformance with the rules of the Michigan Board of Land Surveyors or by a Decree of a Court of Law; established, re-established, monumented, recovered, found as expressed below:

1	A	B	C	D	E	F	G	H	I	J	K	L	M
2		6		5		4		3		2		1	
3													
4		7		8		9		10		11		12	
5													
6		18		17		16		15		14		13	
7													
8		19		20		21		22		23		24	
9													
10		30		29		28		27		26		25	
11													
12		31		32		33		34		35		36	
13													

NOTE: Not more than 2 corners, all in the same Town and Range, may be recorded on this certificate.

A. Description of original monument and accessories and/or subsequent restoration:

B-7
POST SET BY J. BURT, JULY 1843
8" MAPLE S67°E 28 LINKS
7" MAPLE N18°W 6 LINKS

-FIELD NOTES FROM WADE-TRIM/EDMANDS CERTIFICATE OF SURVEY RECORDED IN L. 2, P. 70, JUNE 1993, PAUL M. CIOSEK, PS#25835, FOUND 3/4" PIPE.


B. Description of corner evidence found and/or method applied in restoring or reestablishing corner:

B-7
SEARCHED THE APPARENT LOCATION OF THE CORNER AND FOUND A 1" BAR.
FOUND NO RECORDED INFORMATION FOR THIS CORNER.
VERIFIED WITNESSES FROM WADE-TRIM/EDMANDS FIELD NOTES, S 22°W TO THE NE CORNER ATTACHED GARAGE OF HOUSE #2737 139.86'(R) 139.75'(M), S 13°W TO CENTERLINE OF SOUTH END 42" CMP 19.85'(R) 19.89'(M), N 15°W TO CENTERLINE OF NORTH END 42" CMP 15.85'(R) 15.89'(M).
EXCAVATED POINT AND FOUND NO OTHER MONUMENTATION.
THE 1" BAR WAS ACCEPTED AS THE BEST AVAILABLE EVIDENCE OF THE POSITION OF THE ORIGINAL CORNER.

C. Description of monument for corner and accessories established to perpetuate locating the position of the corner:

B-7
REPLACED THE 1" BAR WITH 5/8"x 24" LONG REROD WITH ARENAC COUNTY REMONUMENTATION CAP IN MONUMENT BOX.
S 34°W 19.64' TO PK NAIL IN SOUTH END 48" CMP
N 02°W 15.82' TO NW BOLT ON NORTH END 48" CMP
S 82°W 53.09' TO PK NAIL IN EAST END 15" CMP UNDER DRIVE TO HOUSE #2737
S 48°E 46.21' TO PK NAIL IN EAST END 15" CMP UNDER FIELD DRIVE
N 08°W 24.82' TO PK IN SOUTH END 8" CMP FIELD DRAIN
SOUTH ± 1' TO PHYSICAL CENTERLINE SAGATOO ROAD.

ACCEPTED BY THIS ARENAC COUNTY SURVEY PEER GROUP AS THE OFFICIAL CORNER UNDER MICHIGAN PUBLIC ACT 345 OF 1990 AT A MEETING HELD ON NOV 9, 1999
Paul M. Ciosek
PAUL M. CIOSEK P.S., CHAIRMAN

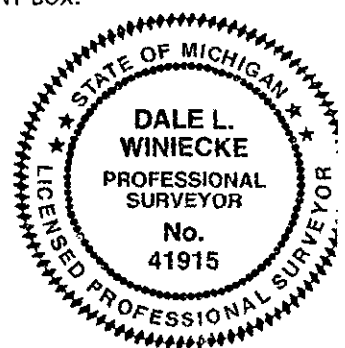

Signed by Dale Winiecke
Surveyor's Michigan License No. 41915

Date 12/30/99