

**ARENAC COUNTY REMONUMENTATION
LAND CORNER RECORDATION CERTIFICATE
Filing Requirement of Act 74, Mich. P.A. 1970**

For corners in

ARENAC
(County)

Located In:

Corner Code ROSE SMITH

LC 2/ 139

Page 1 of 1

ARENAC CO. REG. OF DEEDS

RS Rec. Date 12/23/97 Time 11:43
RECORDING FEES: 9.00

- | | | |
|------------------------------------|-------------------------------------------|-------------|
| 1. Public Land Survey | <u>T18N R5E</u> | <u>B-9</u> |
| | T <u> </u> R <u> </u> | <u> </u> |
| | T <u> </u> R <u> </u> | <u> </u> |
| | T <u> </u> R <u> </u> | <u> </u> |
| 2. Property Controlling in Section | S <u> </u> T <u> </u> R <u> </u> | <u> </u> |
| | S <u> </u> T <u> </u> R <u> </u> | <u> </u> |
| 3. Miscellaneous Property in Sec. | S <u> </u> T <u> </u> R <u> </u> | <u> </u> |
| | S <u> </u> T <u> </u> R <u> </u> | <u> </u> |

Register of Deeds Stamp & File Number

4. Lot No. _____, Recorded Plat _____

5. Private Claims _____

I, MICHAEL J. MACDONALD, in a field survey on OCTOBER 23, 1997 do hereby state that under requirements of P.A. 74, Michigan P.A. of 1970, the corner points mentioned in lines 1 and 2 above were in conformance with regulations and rules therefore as required in the current manual of survey instructions of the United States Department of the Interior, Bureau of Land Management or by a decree of a Court of Law and /or that the corner points mentioned in lines 3, 4 and 5 above were in conformance with the rules of the Michigan Board of Land Surveyors or by a Decree of a Court of Law; established, re-established, monumented, recovered, found as expressed below:

	A	B	C	D	E	F	G	H	I	J	K	L	N
1													
2		6		5		4		3		2		1	
3													
4		7		8		9		10		11		12	
5													
6		18		17		16		15		14		13	
7													
8		19		20		21		22		23		24	
9													
10		30		29		28		27		26		25	
11													
12		31		32		33		34		35		36	
13													

NOTE: Not more than 2 corners, all in the same town and range, may be recorded on this certificate.

A. Description of original monument and accessories and/or subsequent restoration:

B-9

- ORIGINAL POST SET J. BURT D.S. JULY 1843
BLACK ASH 9" N 7"E 11 LINKS
CEDAR 10" S 17"W 22 LINKS
- EDMANDS ENG. WITNESSES, SET RR SPIKE, NO DATE
N 60°W 89.3' TO SE CORNER TWP. HALL, 36.0' TO 28" CEDAR STUMP
- SURVEY, L. 1, P. 219, MACDONALD, (1976) FND 3/4" PIPE
N 60°W 89.3' TO SE CORNER TWP. HALL, 36.0' TO 28" ELM STUMP

**SURVEY &
REMONUMENTATION**

MAR 05 1998

SECTION

B. Description of corner evidence found and/or method applied in restoring or reestablishing corner:

B-9

SEARCHED THE APPARENT LOCATION OF THE CORNER AND FOUND A 3/4" PIPE, 16" LONG. EXCAVATED THE AREA AND FOUND NO OTHER MONUMENTS. PIPE FITS WITNESSES FROM EDMANDS ENG. WITNESS SHEET. 3/4" PIPE ACCEPTED AS THE BEST AVAILABLE EVIDENCE OF THE POSITION OF THE ORIGINAL CORNER.

C. Description of monument for corner and accessories established to perpetuate locating the position of the corner:


B-9

REPLACED 3/4" PIPE WITH 5/8" x 24" LONG REROD WITH ARENAC CO. REMONUMENTATION CAP WITH 1/8" DRILL HOLE.
N 60° W 88.97' SE CORNER TWP HALL
S 20° W 71.50' SET N/T NORTH FACE U. POLE
S 45° W 64.71' NW CORNER METAL I-BEAM POST
N 50° W 43.05' SET N/T E. FACE CLUMP OF ELMS
N 30° E 38.29' SET N/T W. FACE 10" ELM

Signed by Michael J. MacDonald

Surveyor's Michigan License No. 22438

FIELD BOOK 2, PAGE 57

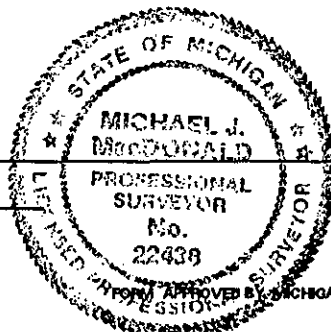

Date 18 Dec 97

ACCEPTED BY THIS ARENAC COUNTY SURVEY PEER GROUP AS THE OFFICIAL CORNER UNDER MICHIGAN PUBLIC ACT 345 OF 1990 AT "A" MEETING HELD ON 10/30/97
Paul M. Ciosek
PAUL M. CIOSEK P.S., CHAIRMAN

APPROVED BY MICHIGAN STATE BOARD OF PROFESSIONAL SURVEYORS, JAN. 29, 1971
REVISED MAY 14, 197
REVISED JAN. 199
REVISED OCT., 199