

**ARENAC COUNTY REMONUMENTATION
LAND CORNER RECORDATION CERTIFICATE
Filing Requirement of Act 74, Mich. P.A. 1970**

RECORDED

JAN 25 2000

For corners in

ARENAC COUNTY Located In: Corner Code #
(County)

1. Public Land Survey T 18N R 5E C-6
T ___ R ___
T ___ R ___
T ___ R ___

2. Property Controlling S ___ T ___ R ___
in Section S ___ T ___ R ___

3. Miscellaneous S ___ T ___ R ___
Property in Sec. S ___ T ___ R ___

Page 1 of 1
ROSE SMITH
ARENAC CD. REG. OF DEEDS
RS Date 01/06/2000 Time 10:08:54
RECORDING FEES: 9.00
LC 2/205
1P

Register of Deeds Stamp & File Number

4. Lot No. _____, Recorded Plat _____

5. Private Claims _____

	A	B	C	D	E	F	G	H	I	J	K	L	M
1													
2	6		5		4		3		2		1		
3													
4	7		8		9		10		11		12		
5													
6	18	●	17		16		15		14		13		
7													
8	19		20		21		22		23		24		
9													
10	30		29		28		27		26		25		
11													
12	31		32		33		34		35		36		
13													

I, DALE L. WINIECKE, in a field survey on JULY, 1999 do hereby state that under requirements of P.A. 74, Michigan P.A. of 1970, the corner points mentioned in lines 1 and 2 above were in conformance with regulations and rules therefore as required in the current manual of survey instructions of the United States Department of the Interior, Bureau of Land Management or by a decree of a Court of Law and /or that the corner points mentioned in lines 3, 4 and 5 above were in conformance with the rules of the Michigan Board of Land Surveyors or by a Decree of a Court of Law; established, re-established, monumented, recovered, found as expressed below:

NOTE: Not more than 2 corners, all in the same Town and Range, may be recorded on this certificate.

A. Description of original monument and accessories and/or subsequent restoration:

C-6
POST SET BY J. BURT, JULY 1843
12" HEMLOCK N32E°W 14 LINKS
12" HEMLOCK S43°W 22 LINKS
CO. SUR NOTES 1908 BOOK 7, PAGE 11
CERTIFICATE OF SURVEY RECORDED IN L. 2, P. 70, PAUL M. CIOSEK, PS#25835, JUNE 1993, FOUND 3/4" IRON WITH BRASS CAP.

B. Description of corner evidence found and/or method applied in restoring or reestablishing corner:


C-6
SEARCHED THE APPARENT LOCATION OF THE CORNER AND FOUND 3/4" IRON WITH BRASS CAP AND 1/2" REBAR 5.3 EAST OF BRASS CAP. CHECKED WITNESSES FROM CERT OF SURVEY FOR THE BRASS CAP, EAST TO NORTH LEG ROAD SIGN 16.5' (R) 16.15' (M); S40°E TO NAIL IN SW'LY FACE 8" ELM 33.15' (R) 33.22' (M); S40°W TO NE CORNER HOUSE #4042, 99.10' (R) 99.32' (M). EXCAVATED BRASS CAP AND FOUND PART OF PLOW BLADE AND R/R SPIKE WITH NAILS BELOW. DISTANCES CHECKED FROM COUNTY SURVEYOR NOTES ARE IN AGREEMENT SOUTH 2640' (R) 2640.95' (M) NORTH 2616.90' (R) 2613.55' (M); DEFLECTION ANGLE AT THE CORNER CHECKED FROM COUNTY SURVEYOR NOTES ANGLE TO THE RIGHT 50 MINUTES (R) 1°05'43" (M) EXCAVATED 1/2" REBAR AND FOUND NOTHING BELOW.

3/4" IRON WITH BRASS CAP ACCEPTED AS THE BEST EVIDENCE OF THE POSITION OF THE ORIGINAL CORNER.

C. Description of monument for corner and accessories established to perpetuate locating the position of the corner:

C-6
REPLACED THE 3/4" IRON AND BRASS CAP WITH 5/8"x 24" LONG REROD WITH ARENAC COUNTY REMONUMENTATION CAP.
S82°E 16.15' TO NORTH LEG OF ROAD SIGN
S32°E 33.22' TO NAIL IN SW'LY FACE 8" ELM
S70°W 99.32' TO NORTHEAST CORNER HOUSE #4042
N30°E 39.83' SET 1/2" IRON WITH CAP PS#41915
N70°W 86.13' TO NAIL AND TAG IN S'LY DOUBLE ELM
N08°W 50.85' SET 1/2" IRON WITH CAP PS#41915
S26°W 87.28' TO NAIL AND TAG IN E'LY FACE 10" PINE
EAST 2.5' ± TO PHYSICAL CENTERLINE OF LENTZ
SOUTH 1.0' ± TO PHYSICAL CENTERLINE OF IRWIN ROAD

ACCEPTED BY THE ARENAC COUNTY SURVEYOR PEER GROUP AS THE OFFICIAL CORNER UNDER MICHIGAN PUBLIC ACT 345 OF 1990 AT A MEETING HELD ON
NOV 19, 1999
Paul M. Ciosek
PAUL M. CIOSEK, CHAIRMAN

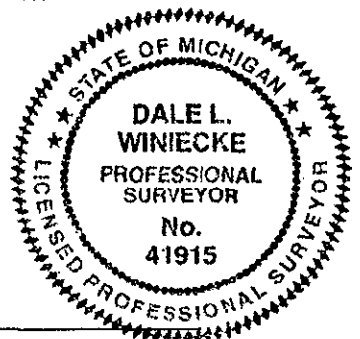

Signed by Dale Winiecke

Date 12/30/99

Surveyor's Michigan License No. 41915