

**ARENAC COUNTY REMONUMENTATION
LAND CORNER RECORDATION CERTIFICATE
Filing Requirement of Act 74, Mich. P.A. 1970**

RECORDED

JAN 25 2000

For corners in

<u>ARENAC COUNTY</u> (County)	Located In:	Corner Code #
1. Public Land Survey	T <u>18N</u> R <u>5E</u>	<u>D-5</u>
	T _____ R _____	_____
	T _____ R _____	_____
	T _____ R _____	_____
2. Property Controlling in Section	S _____ T _____ R _____	_____
	S _____ T _____ R _____	_____
3. Miscellaneous Property in Sec.	S _____ T _____ R _____	_____
	S _____ T _____ R _____	_____

SECTION

Page 1 of 1
ROSE SMITH
ARENAC CO. REG. OF DEEDS
RS Date 01/06/2000
RECORDING FEES: 9.00
LC 2/208
1P
Time 10:10:10
Register of Deeds Stamp & File Number

4. Lot No. _____, Recorded Plat _____

5. Private Claims _____

I, DALE L. WINIECKE, in a field survey on NOVEMBER, 1999 do hereby state that under requirements of P.A. 74, Michigan P.A. of 1970, the corner points mentioned in lines 1 and 2 above were in conformance with regulations and rules therefore as required in the current manual of survey instructions of the United States Department of the Interior, Bureau of Land Management or by a decree of a Court of Law and /or that the corner points mentioned in lines 3, 4 and 5 above were in conformance with the rules of the Michigan Board of Land Surveyors or by a Decree of a Court of Law; established, re-established, monumented, recovered, found as expressed below:

1	A	B	C	D	E	F	G	H	I	J	K	L	M
2		6		5		4		3		2		1	
3													
4		7		8		9		10		11		12	
5				●									
6		18		17		16		15		14		13	
7													
8		19		20		21		22		23		24	
9													
10		30		29		28		27		26		25	
11													
12		31		32		33		34		35		36	
13													

NOTE: Not more than 2 corners, all in the same Town and Range, may be recorded on this certificate.

A. Description of original monument and accessories and/or subsequent restoration:

D-5
POST SET BY J. BURT, JULY 1843
18" MAPLE S73°E 11 LINKS
12" BLACK ASH N54 16 LINKS


CO. SUR. NOTES, 1905 BOOK 5, PAGE 27; BEARING AND DIST ALONG SOUTH LINE
EDMANDS ENGINEERING FIELD NOTES 1972 FOR SECTION BREAKDOWN OF SECTION 8

B. Description of corner evidence found and/or method applied in restoring or reestablishing corner:

D-5
SEARCHED THE APPARENT LOCATION OF THE CORNER AND FOUND NOTHING.
CORNER RESET BY HOLDING THE DISTANCE C-5 TO D-5 ACCORDING TO THE 1905 COUNTY SURVEYOR NOTES AND EDMANDS SECTION BREAKDOWN AND DEFLECTION ANGLE AS SHOWN ON THE SECTION BREAKDOWN. THIS POSITION FITS THE LOCATION OF THE NORTH-SOUTH 1/4 LINE AS MONUMENTED BY HOLDING THE NORTH 1/4 CORNER AND PROJECTING A LINE THROUGH THE EXISTING CENTER OF SECTION. THIS LOCATION FALLS SIX FEET EAST OF FIELD LINE RUNNING SOUTHERLY.
EXCAVATED AREA AND FOUND NO OTHER MONUMENTATION
THE RESET CORNER WAS ACCEPTED AS THE BEST EVIDENCE OF THE POSITION OF THE ORIGINAL CORNER.

C. Description of monument for corner and accessories established to perpetuate locating the position of the corner:

D-5
SET 5/8"x 24" LONG REROD WITH ARENAC COUNTY REMONUMENTATION CAP.
N15°E 19.10' TO PK NAIL IN WEST END 15" CMP
S70°W 27.74' TO PK NAIL EAST END 12" CMP
S16°E 149.19' TO NW CORNER HOUSE #2243
S60°E 125.98' TO NAIL AND TAG IN NORTH FACE UTILITY POLE
S04°E 50.35' TO NAIL AND TAG IN WEST FACE 6" POPLAR TREE
S08°E 29.75' TO NAIL AND TAG IN NE FACE 5" POPLAR TREE
NORTH ± 2' TO THE PHYSICAL CENTERLINE OF PALMER ROAD

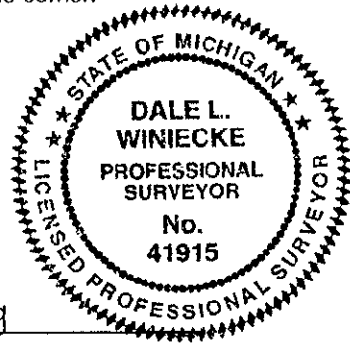

Signed by Dale Winiecke
Surveyor's Michigan License No. 41915

Date 12/30/99

NOV 9 1999
RECORDED
ROSE SMITH