

**ARENAC COUNTY REMONUMENTATION
LAND CORNER RECORDATION CERTIFICATE
Filing Requirement of Act 74, Mich. P.A. 1970**

RECORDATION NO

JAN 25 2000

For corners in

<u>ARENAC COUNTY</u> (County)	Located In:	Corner Code #
1. Public Land Survey	T <u>18N</u> R <u>5E</u>	<u>E-4</u>
	T ___ R ___	___
	T ___ R ___	___
	T ___ R ___	___
2. Property Controlling in Section	S ___ T ___ R ___	___
	S ___ T ___ R ___	___
3. Miscellaneous Property in Sec.	S ___ T ___ R ___	___
	S ___ T ___ R ___	___

SECTION

Page 1 of 1
ROSE SMITH
ARENAC CO. REG. OF DEEDS
RS Date 01/06/2000 Time 10:11:01
RECORDING FEES: 9.00

LC 2/210
1P

Register of Deeds Stamp & File Number

4. Lot No. _____, Recorded Plat _____

5. Private Claims _____

	A	B	C	D	E	F	G	H	I	J	K	L	M
1													
2	6		5		4		3		2		1		
3													
4	7		8		9		10		11		12		
5													
6	18		17		16		15		14		13		
7													
8	19		20		21		22		23		24		
9													
10	30		29		28		27		26		25		
11													
12	31		32		33		34		35		36		
13													

I, DALE L. WINIECKE, in a field survey on NOVEMBER, 1999 do hereby state that under requirements of P.A. 74, Michigan P.A. of 1970, the corner points mentioned in lines 1 and 2 above were in conformance with regulations and rules therefore as required in the current manual of survey instructions of the United States Department of the Interior, Bureau of Land Management or by a decree of a Court of Law and /or that the corner points mentioned in lines 3, 4 and 5 above were in conformance with the rules of the Michigan Board of Land Surveyors or by a Decree of a Court of Law; established, re-established, monumented, recovered, found as expressed below:

NOTE: Not more than 2 corners, all in the same Town and Range, may be recorded on this certificate.

A. Description of original monument and accessories and/or subsequent restoration:

E-4
POST SET BY J. BURT, JULY 1843
11" CEDAR N03°W 25 LINKS


CERTIFICATE OF SURVEY, L. 1, P. 41, LLOYD MCGINNIS, PS #18999, MAY 1972, NO CALL OR WITNESSES
CERTIFICATE OF SURVEY, L. 1, P. 42, LLOYD MCGINNIS, PS #18999, MAY 1972, NO CALL OR WITNESSES
CERTIFICATE OF SURVEY, L. 1, P. 43, LLOYD MCGINNIS, PS #18999, MAY 1972, NO CALL OR WITNESSES
CERTIFICATE OF SURVEY, L. 1, P. 52, LLOYD MCGINNIS, PS #18999, MAY 1972, NO CALL OR WITNESSES
CERTIFICATE OF SURVEY, L. 1, P. 487, RICHARD MILLER, PS #16050, APRIL 1983, NO CALL OR WITNESSES

B. Description of corner evidence found and/or method applied in restoring or reestablishing corner:

E-4
SEARCHED THE APPARENT LOCATION OF THE CORNER AND FOUND 1/2" REROD.
EXCAVATED POINT AND FOUND NO OTHER MONUMENTATION.
ACCEPTED THE 1/2" REROD AS THE BEST EVIDENCE OF THE POSITION OF THE ORIGINAL CORNER.

C. Description of monument for corner and accessories established to perpetuate locating the position of the corner:

E-4
REPLACED THE 1/2" REBAR WITH 5/8"x 24" LONG REROD WITH ARENAC COUNTY REMONUMENTATION CAP.
S70°W 26.15' TO CHISELED 'X' IN NORTH END CENTERLINE OF BLOCK HEADWALL.
S40°E 24.40' TO MAG NAIL IN SOUTH END 12" CMP
N40°E 29.67' TO MAG NAIL IN NORTH END 12" CMP
WEST 53.57' TO NAIL AND TAG IN SOUTH FACE UTILITY POLE
N20°W 115.38' TO NAIL AND TAG IN SW FACE OF UTILITY POLE
N60°W 109.70' TO NE CORNER HOUSE (NO NUMBER)
EAST ± 2' TO PHYSICAL CENTERLINE OF LACLAIR ROAD

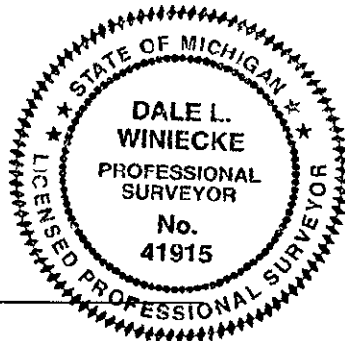

Signed by Dale Winiecke
Surveyor's Michigan License No. 41915

Date 12/30/99

