

**ARENAC COUNTY REMONUMENTATION
LAND CORNER RECORDATION CERTIFICATE**
Filing Requirement of Act 74, Mich. P.A. 1970

RECORDED

For corners in

ARENAC COUNTY Located In: Corner Code #
(County)

1. Public Land Survey T 18N R 5E E-6
T ___ R ___
T ___ R ___
T ___ R ___

2. Property Controlling S ___ T ___ R ___
in Section S ___ T ___ R ___

3. Miscellaneous S ___ T ___ R ___
Property in Sec. S ___ T ___ R ___

JAN 25 2000

SECTION

Page 1 of 1
ROSE SMITH
ARENAC CO. REG. OF DEEDS
RS Date 01/06/2000 Time 10:12:04
RECORDING FEES: 9.00

LC 2/212
1P

Register of Deeds Stamp & File Number

4. Lot No. _____, Recorded Plat _____

5. Private Claims _____

I, DALE L. WINIECKE, in a field survey on NOVEMBER, 1999 do hereby state that under requirements of P.A. 74, Michigan P.A. of 1970, the corner points mentioned in lines 1 and 2 above were in conformance with regulations and rules therefore as required in the current manual of survey instructions of the United States Department of the Interior, Bureau of Land Management or by a decree of a Court of Law and /or that the corner points mentioned in lines 3, 4 and 5 above were in conformance with the rules of the Michigan Board of Land Surveyors or by a Decree of a Court of Law; established, re-established, monumented, recovered, found as expressed below:

1	A	B	C	D	E	F	G	H	I	J	K	L	M
2		6		5		4		3		2		1	
3													
4		7		8		9		10		11		12	
5													
6		18		17	●	16		15		14		13	
7													
8		19		20		21		22		23		24	
9													
10		30		29		28		27		26		25	
11													
12		31		32		33		34		35		36	
13													

NOTE: Not more than 2 corners, all in the same Town and Range, may be recorded on this certificate.

A. Description of original monument and accessories and/or subsequent restoration:

E-6
POST SET BY J. BURT, JULY 1843
20" BLACK ASH N50°E 9 LINKS
10" ELM N42 1/2°W 14 LINKS


EDMANDS ENGINEERING WITNESSES 1965, 1 1/2" PIPE

B. Description of corner evidence found and/or method applied in restoring or reestablishing corner:

E-6
SEARCHED THE APPARENT LOCATION OF THE CORNER AND FOUND 1 1/2" PIPE.
FOUND NO INFORMATION RECORDED FOR THIS CORNER.
CHECKED EDMANDS ENGINEERING WITNESSES FROM NOTES SW TO P. POLE 56.3' (R) TO SET NAIL & TAG IN SE FACE U. POLE 52.85'(M)
EXCAVATED POINT AND FOUND 1" PIPE BELOW WITH METAL BRACKETS SURROUNDING THE PIPE
THE 1 1/2" PIPE WAS ACCEPTED AS THE BEST EVIDENCE OF THE POSITION OF THE ORIGINAL CORNER.

C. Description of monument for corner and accessories established to perpetuate locating the position of the corner:

E-6
REPLACED THE 1 1/2" PIPE WITH 5/8"x 24" LONG REROD WITH ARENAC COUNTY REMONUMENTATION CAP.
N48°E 28.60' TO EAST END OF 36"CMP
N30°W 49.75' TO C/L SIGN POST
N50°W 60.70' TO NAIL IN 8" APPLE TREE
S60°W 40.60' TO C/L SIGN POST
N82°E 33.48' TO C/L SIGN POST
SOUTH ±3.5' TO PHYSICAL CENTERLINE OF IRWIN ROAD
WEST ±1' TO PHYSICAL CENTERLINE OF LACLAIR ROAD

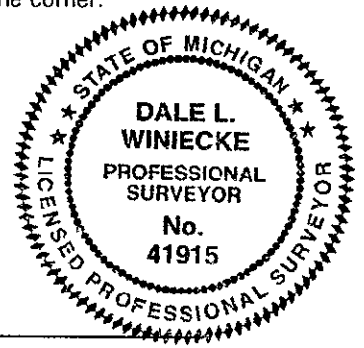

Signed by Dale Winiecke

Date 12/30/99

Surveyor's Michigan License No. 41915

