

LAND CORNER RECORDATION CERTIFICATE

FILING REQUIREMENT OF ACT 74, MICH. P.A.1970

FOR CORNERS OF--:	LOCATED IN--:	CORNER CODE NUMBER
1. PUBLIC LAND SURVEY <u>1</u> T. <u>19</u> N. <u>●</u> , R. <u>3</u> E. <u>●</u>		<u>L-1; K-1</u>
2. PROPERTY CONTROLLING IN SECTION _____, T. _____, N. _____, S. _____, R. _____, E. _____, W. _____		
3. MISCELLANEOUS PROPERTY IN SECTION _____, T. _____, N. _____, S. _____, R. _____, E. _____, W. _____		
4. LOT NO. _____, RECORDED PLAT _____		
5. PRIVATE CLAIMS _____		

REGISTER OF DEEDS STAMP AND FILING NUMBER

I, KENNETH J. OSTLING, do hereby certify that under requirements of P.A. 74, Michigan P.A. of 1970, the corner points mentioned in lines 1 and 2 above were, in a field survey on FEBRUARY 23, 1982, established, re-established, monumented, re-monumented, recovered or restored as expressed below and in conformance with regulations and rules therefore as required in the current manual of survey instructions of the United States Department of the Interior, Bureau of Land Management or by a decree of a court of law. Furthermore, that the corner points mentioned in lines 3, 4 and 5 above were, in a field survey on _____, 19____, found, recovered, restored, established or re-established as expressed below and in conformance with the rules of the Michigan State Board of Registration for Land Surveyors or, by a Decree of a Court of law:

A. Description of original monument and accessories and/or subsequent restoration:

B. Description of corner evidence found and/or method applied in restoring or re-establishing corner:

L-1 SET BY PROPORTIONATE MEASUREMENT BETWEEN SECTION CORNERS.

K-1 SET THIS CORNER AT RECORD MEASUREMENT EASTERLY OF STANDARD CORNER, NO SIGN OF ANY PREVIOUS CORNER.

C. Description of monument for corner and accessories established to perpetuate locating the position of the corner:

<u>L-1</u>	<u>K-1</u>
SET DNR MONUMENT	SET DNR MONUMENT
5" R. MAPLE S50°W 15.1'	12" R. MAPLE S27°W 73.8'
2" R. MAPLE S68°E 5.2'	16" R. MAPLE S24°E 76.1'
S 1/4 SEC 36 N89°30'38"W 6.27'	SW COR SEC 36 N89°30'38"W 12.54'

SIGNED BY Kenneth J. Ostling

DATE _____

SURVEYOR'S MICHIGAN REGISTRATION NO. #10068

FOR STATE AND UNITED STATES AGENCIES:

SIGNED BY _____

DATE _____


CHIEF OF SURVEY PARTY

APPROVED AND SIGNED BY _____

DATE _____

MICHIGAN REGISTERED LAND SURVEYOR

(SEAL)

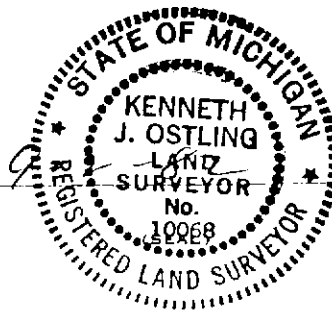

SURVEYOR'S MICHIGAN REGISTRATION NO. _____

ARENAC COUNTY