

LAND CORNER RECORDATION CERTIFICATE

Filing Requirement of Act 74, Mich. PA 1970

For Corners In: Arenac Located In _____ Corner Code # _____
 (County)

1. Public Land Survey T 19N R 3E B1
 T _____ R _____
 2. Property Controlling in Section S _____ T _____ R _____
 S _____ T _____ R _____
 3. Miscellaneous Property in Section S _____ T _____ R _____
 S _____ T _____ R _____

4. Lot No: _____ Recorded Plat: _____

5. Private Claims: _____

I, Craig W. McVean, in a field survey on Nov. 9, 2004 do hereby state that under requirements of PA 74, Michigan PA of 1970, the corner points mentioned in lines 1 and 2 above were in conformance with regulations and rules therefore as required in the current manual of survey instructions of the United States Department of the Interior, Bureau of Land Management or by a decree of a Court of Law and/or that the corner points mentioned in lines 3, 4 and 5 above were in conformance with the rules of the Michigan Board of Land Surveyors or by a Decree of a Court of Law; established, re-established, monumented, recovered, found as expressed below:

NOTE: Not more than 2 corners, all in the same town and range, may be recorded on this certificate.

Register of Deeds Stamp & File Number

	A	B	C	D	E	F	G	H	I	J	K	L	M
1		●											
2	6		5		4		3		2		1		
3													
4	7		8		9		10		11		12		
5													
6	18		17		16		15		14		13		
7													
8	19		20		21		22		23		24		
9													
10	30		29		28		27		26		25		
11													
12	31		32		33		34		35		36		
13													


A. Description of original monument and accessories and/or subsequent restoration:
B1 – GLO – Not set in original survey

B. Description of corner evidence found and/or method applied in restoring or re-establishing corner:

B1 – Closing ¼ Corner common to Sec. 6 – Set 4" DNR Alum. Cap on 1" x 5' long galv. Iron pipe single proportion to GLO protraction on standard line per standard BLM procedure. Corner in swampy area. DNR Mon. accepted as the best available evidence of the position of the corner.

C. Description of monument for corner and accessories established to perpetuate locating the position of the corner:

B1 – 4" DNR Alum. Cap on 1" x 5' long galv. Iron pipe
 Set Blue Carsonite Post 1' S
 West 9.88' to 'B13', T20N, R3E – DNR Mon.
 S9°W 35.52' to set N & T in W. side 10" Tw. R. Maple scribed 'XBT'
 S89°W 47.85' to set N & T in S. side 37" R. Maple scribed 'XBT'
 N54°W 51.83' to set N & T in E. side 37" R. Maple scribed 'XBT'
 N34°E 53.05' to set N & T in SE side 20" Tw. R. Maple scribed 'XBT'

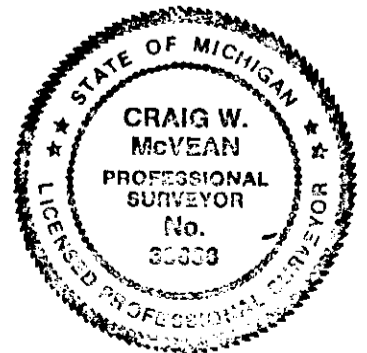

Signed by: Craig W. McVean
 Surveyor's Michigan License No.: 39088

Date: 2/7/2005