

LAND CORNER RECORDATION CERTIFICATE

* Filing Requirement of Act 74, Mich. PA 1970

For Corners In: <u>Arenac</u> (County)	Located In T <u>19N</u> R <u>3E</u> C1 T _____ R _____ S _____ T _____ R _____ S _____ T _____ R _____ S _____ T _____ R _____ S _____ T _____ R _____	Corner Code # _____ _____ _____ _____ _____
--	--	--

Register of Deeds Stamp & File Number

4. Lot No: _____ Recorded Plat: _____

5. Private Claims: _____

I, Craig W. McVean, in a field survey on Oct. 27, 2004 do hereby state that under requirements of PA 74, Michigan PA of 1970, the corner points mentioned in lines 1 and 2 above were in conformance with regulations and rules therefore as required in the current manual of survey instructions of the United States Department of the Interior, Bureau of Land Management or by a decree of a Court of Law and/or that the corner points mentioned in lines 3, 4 and 5 above were in conformance with the rules of the Michigan Board of Land Surveyors or by a Decree of a Court of Law; established, re-established, monumented, recovered, found as expressed below:

NOTE: Not more than 2 corners, all in the same town and range, may be recorded on this certificate.

	A	B	C	D	E	F	G	H	I	J	K	L	M
1													
2	6		5		4		3		2		1		
3													
4	7		8		9		10		11		12		
5													
6	18		17		16		15		14		13		
7													
8	19		20		21		22		23		24		
9													
10	30		29		28		27		26		25		
11													
12	31		32		33		34		35		36		
13													

A. Description of original monument and accessories and/or subsequent restoration:


- C1 – GLO – Inter. Townline 15 L. East
of corner 31 & 32 – Set Post at inter. –
John Mullett – 1846
- B. Ash 8" S21°W 35 L.
- B. Ash 7" S32°E 32 L.
- CPC Survey – Drawing #SF 16955 – Sheet 97 - 1968
- Corner set – Standard Cor. 9.9' West

B. Description of corner evidence found and/or method applied in restoring or re-establishing corner:

- C1 – Closing Corner common to Sec. 5 & 6, T19N, R3E – Found bent and leaning 3/8" x 18" rebar and CPC 'T' iron on standard line 9.9' East of standard corner. Corner on East line of Powerline corridor. Bent 'T' and 3/8" irons accepted as the best available evidence of the position of the original corner.

C. Description of monument for corner and accessories established to perpetuate locating the position of the corner:

- C1 – Replaced bent 3/8" x 18" rebar and bent 18" long 'T' iron with 4" DNR Alum. Cap on 1" x 36" Galv. iron pipe.
Set Blue Carsonite Post 1' E
N69°E 57.53' to set N & T in N. side 16" Tw. R. Maple scribed 'XBT'
East 55.82' to set N & T in N side 11" Oak scribed 'CCBT'
S32°E 57.53' to set N & T in SW side 6" Ash
West 9.9' to 'C13', T20N, R3E – DNR Mon.

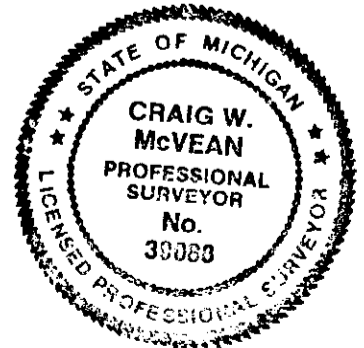

Signed by: Craig W. McVean
 Surveyor's Michigan License No.: 39088

Date: 2/7/2005