

LAND CORNER RECORDATION CERTIFICATE

Filing Requirement of Act 74, Mich. PA 1970

For Corners In:

Arenac
(County)

Located In

Corner Code #



- | | | | | | | | | |
|--------------------------------------|--|---|------------|--|---|-----------|--|-------|
| 1. Public Land Survey | | T | <u>19N</u> | | R | <u>3E</u> | | C4 |
| | | T | _____ | | R | _____ | | _____ |
| 2. Property Controlling in Section | | S | _____ | | T | _____ | | _____ |
| | | S | _____ | | T | _____ | | _____ |
| 3. Miscellaneous Property in Section | | S | _____ | | T | _____ | | _____ |
| | | S | _____ | | T | _____ | | _____ |

4. Lot No: _____ Recorded Plat: _____

5. Private Claims: _____

I, Craig W. McVean, in a field survey on March 22, 2005 do hereby state that under requirements of PA 74, Michigan PA of 1970, the corner points mentioned in lines 1 and 2 above were in conformance with regulations and rules therefore as required in the current manual of survey instructions of the United States Department of the Interior, Bureau of Land Management or by a decree of a Court of Law and/or that the corner points mentioned in lines 3, 4 and 5 above were in conformance with the rules of the Michigan Board of Land Surveyors or by a Decree of a Court of Law; established, re-established, monumented, recovered, found as expressed below:

NOTE: Not more than 2 corners, all in the same town and range, may be recorded on this certificate.

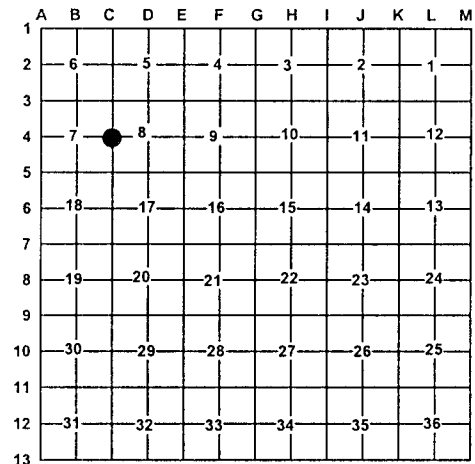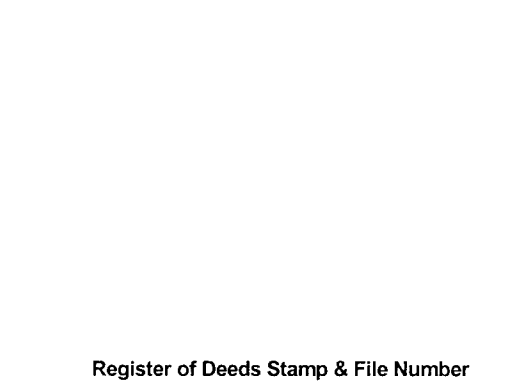

A. Description of original monument and accessories and/or subsequent restoration:

- C4 – GLO – Set ¼ Post – J. Mullett – 1846
- Y. Pine 8" S52°E 13 L.
- Y. Pine 12" N48°W 5 L.
- CCC Notes – 1930's – Random line
- S. No corner noted.
- CPC Survey – Drawing #SF16944 – Sheet 99
- Corner set; 16" Pine S20°E 63.00';
- 18" Pine S60°E 59.00'

B. Description of corner evidence found and/or method applied in restoring or re-establishing corner:

C4 – ¼ Corner common to Sec. 7 & 8 – Fd. Consumer's 'T' iron that fit their BT's. No conclusive GLO evidence found. Consumers' set SP between Sec. Corners 'C5' and 'C1'. Centerline of N-S tower powerline is 114'± W. 'T' iron accepted as the best available evidence of the position of the original corner.

C. Description of monument for corner and accessories established to perpetuate locating the position of the corner:

- C4 – Replaced Consumer's 'T' iron x 18" long with 4" DNR Alum. Cap on 1" x 36" Galv. iron pipe.
- Set Blue Carsonite Post 1' E.
- Reset steel fence post 1' N
- Set 24" B. Pipe (CPC)

