

LAND CORNER RECORDATION CERTIFICATE

Filing Requirement of Act 74, Mich. PA 1970

For Corners In:
Arenac Located In _____ Corner Code # _____
 (County)


1. Public Land Survey T 19N R 3E K6
 T _____ R _____
 2. Property Controlling in Section S _____ T _____ R _____
 S _____ T _____ R _____
 3. Miscellaneous Property in Section S _____ T _____ R _____
 S _____ T _____ R _____

4. Lot No: _____ Recorded Plat: _____

5. Private Claims: _____

I, Craig W. McVean, in a field survey on Nov. 2, 2005 do hereby state that under requirements of PA 74, Michigan PA of 1970, the corner points mentioned in lines 1 and 2 above were in conformance with regulations and rules therefore as required in the current manual of survey instructions of the United States Department of the Interior, Bureau of Land Management or by a decree of a Court of Law and/or that the corner points mentioned in lines 3, 4 and 5 above were in conformance with the rules of the Michigan Board of Land Surveyors or by a Decree of a Court of Law; established, re-established, monumented, recovered, found as expressed below:

NOTE: Not more than 2 corners, all in the same town and range, may be recorded on this certificate.

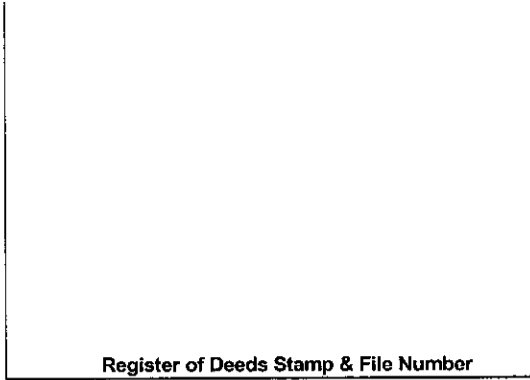

	A	B	C	D	E	F	G	H	I	J	K	L	M
1													
2	6		5		4		3		2		1		
3													
4	7		8		9		10		11		12		
5													
6	18		17		16		15		14	●	13		
7													
8	19		20		21		22		23		24		
9													
10	30		29		28		27		26		25		
11													
12	31		32		33		34		35		36		
13													

A. Description of original monument and accessories and/or subsequent restoration:

K6 – GLO – Set ¼ Post – J. Mullett – 1846
 Beech 6" S78°E 4 L.
 Sugar 10" N80°W 13 L.
 - S.J.E. Lucas – 1914 Survey map. Substantial corner
 - MDOT Wit. Card – 1964 – H. J. Ptaszenski
 (LCRC L. 1, p. 178 – 1984) – Fd. remains of pipe.
 Replaced with 1" pipe – Buried 14"
 N11°W 60.44' to 5" Birch;
 N24°E 63.62' to 9" Maple;
 S3°E 26.72' to Fe. Post

B. Description of corner evidence found and/or method applied in restoring or re-establishing corner:

K6 – ¼ Cor. Common to Sec. 14 & 13 – Fd. 1" I.D. iron pipe in 'T' gravel intersection per MDOT. Fits 2 MDOT Wits. Centerline of Gravel Road N. is 1.5' ± W. Centerline of E-W Gravel Rd. is 3' S. Fence to S. 1" iron pipe accepted as the best available evidence of the position of the original corner.

C. Description of monument for corner and accessories established to perpetuate locating the position of the corner:

K6 – 1" I.D. iron pipe – Down 0.3'
 S2°W 27.10' to fd. MSHD N & T in W. side S'y lean RR tie fence post (MDOT)
 N51°W 40.83' to chiseled 'X' in SE face 5" steel fence post
 S47°E 81.60' to set N & T in NE side PP
 N58°E 49.54' to set N & T in SE side 16" W. Pine
 N22°E 63.62' to set N & T in W. side 26" R. Maple (MDOT)



Signed by: Craig W. McVean
 Surveyor's Michigan License No.: 39088

Date: 11/30/2005