

LAND CORNER RECORDATION CERTIFICATE

Filing Requirement of Act 74, Mich. PA 1970

For Corners In:			
Arenac _____	Located In	Corner Code #	
(County)			
1. Public Land Survey	T _____ R _____		
	T _____ R _____		
2. Property Controlling in Section	S <u>9</u> T <u>19N</u> R <u>3E</u>		<u>11</u>
	S <u>9</u> T <u>19N</u> R <u>3E</u>		<u>10</u>
3. Miscellaneous Property in Section	S _____ T _____ R _____		
	S _____ T _____ R _____		


4. Lot No: _____ Recorded Plat: _____

5. Private Claims: _____

I, Craig W. McVean, in a field survey on Sept. 21, 2005 do hereby state that under requirements of PA 74, Michigan PA of 1970, the corner points mentioned in lines 1 and 2 above were in conformance with regulations and rules therefore as required in the current manual of survey instructions of the United States Department of the Interior, Bureau of Land Management or by a decree of a Court of Law and/or that the corner points mentioned in lines 3, 4 and 5 above were in conformance with the rules of the Michigan Board of Land Surveyors or by a Decree of a Court of Law; established, re-established, monumented, recovered, found as expressed below:

NOTE: Not more than 2 corners, all in the same town and range, may be recorded on this certificate.

Register of Deeds Stamp & File Number

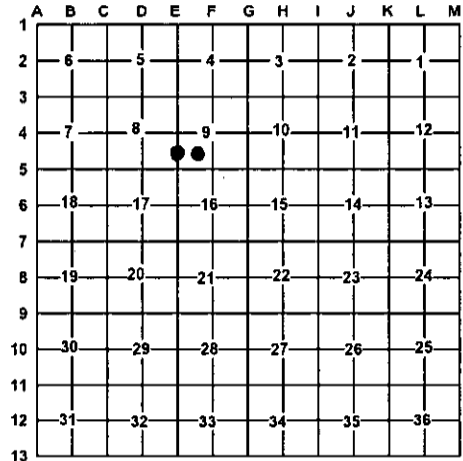

A. Description of original monument and accessories and/or subsequent restoration:

11 - None 10 - None



B. Description of corner evidence found and/or method applied in restoring or re-establishing corner:

<p><u>11</u> - SW 1/16, Sec. 9 - Set 5/8" x 3/4" rebar with stamped 2" Alum. Cap per Standard BLM procedure.</p>	<p><u>10</u> - S 1/16, Cor. common to Sec. 8 & 9 - Set 5/8" x 4" rebar with stamped 2" Alum. Cap per standard BLM procedure Single strand E-W fence is 31' N. Centerline E-W ditch is 15' N.</p>
--	--

C. Description of monument for corner and accessories established to perpetuate locating the position of the corner:

<p><u>11</u> - Set stamped 2" Alum. Cap on 5/8" x 3/4" rebar S48°W 38.34' to set N & T in NE side of 6" Ash S35°E 56.48' to set N & T in SE side of 6" Poplar N27°W 47.66' to set N & T in NE side 6" Maple N32°E 29.06' to set N & T in NW side 13" Poplar Set Blue Carsonite Post with loc. tag 1' NE</p>	<p><u>10</u> - Set 5/8" x 4" iron rebar with stamped 2" Alum. Cap N62°W 53.70' to set N & T in N. side 8" Cherry S88°E 63.71' to set N & T in S. side 8" Elm S45°W 29.18' to set 1/2" x 18" rebar S30°E 30.33' to set 1/2" x 18" rebar Set Blue Carsonite Post with loc. tag 1' N.</p>
---	--

Signed by: Craig W. McVean Date: 11/30/2005
 Surveyor's Michigan License No.: 39088