

# LAND CORNER RECORDATION CERTIFICATE

Filing Requirement of Act 74, Mich. PA 1970

For Corners In:  
Arenac Located In \_\_\_\_\_ Corner Code # \_\_\_\_\_  
 (County)



1. Public Land Survey T 19N R 3E C6  
 T \_\_\_\_\_ R \_\_\_\_\_ \_\_\_\_\_  
 2. Property Controlling in Section S \_\_\_\_\_ T \_\_\_\_\_ R \_\_\_\_\_  
 S \_\_\_\_\_ T \_\_\_\_\_ R \_\_\_\_\_  
 3. Miscellaneous Property in Section S \_\_\_\_\_ T \_\_\_\_\_ R \_\_\_\_\_  
 S \_\_\_\_\_ T \_\_\_\_\_ R \_\_\_\_\_

4. Lot No: \_\_\_\_\_ Recorded Plat: \_\_\_\_\_

5. Private Claims: \_\_\_\_\_

I, Craig W. McVean, in a field survey on Oct. 19, 2005 do hereby state that under requirements of PA 74, Michigan PA of 1970, the corner points mentioned in lines 1 and 2 above were in conformance with regulations and rules therefore as required in the current manual of survey instructions of the United States Department of the Interior, Bureau of Land Management or by a decree of a Court of Law and/or that the corner points mentioned in lines 3, 4 and 5 above were in conformance with the rules of the Michigan Board of Land Surveyors or by a Decree of a Court of Law; established, re-established, monumented, recovered, found as expressed below:

**NOTE: Not more than 2 corners, all in the same town and range, may be recorded on this certificate.**

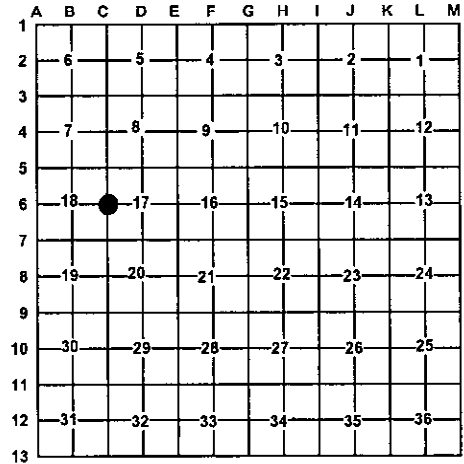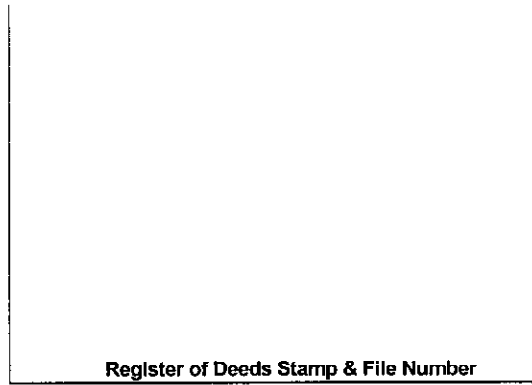

A. Description of original monument and accessories and/or subsequent restoration:

- C6 – GLO – Set ¼ Post – J. Mullett – 1846  
 Tamarack 6" S80°E 20 L.  
 Tamarack 6" N80°W 32 L.  
 - CCC Notes – 1930's – Random S. 350 – Random Post  
 - CPC – Survey Drawing #SF 16944 – Sheet 100-1968  
 Set iron; Fence Cor. N15°E 42.3  
 1 ½" Steel fence post N40°W 65.0'  
 - DNR Survey Proj. #22-93205 – K. J. Ostling – 1984  
 3/8" iron bar. Origin unknown.



B. Description of corner evidence found and/or method applied in restoring or re-establishing corner:

C6 – ¼ Corner common to Sec. 17 & 18 – Fd. 3/8" rebar in open swamp per Consumer's & Ostling. No GLO witnesses found. Fits Consumer's steel fence post Witness. Fence Cor. Wit. NE is 45 feet not 42 feet. Measure South 205'± 5 (198' – GLO) to edge of swamp. North 200'± 10' to edge of swamp (Not called for by GLO). Consumer's drawing shows 'T' irons in 4 directions for Fee Strip ROW but we find none. Did find W'ly deflection point in fee strip to NW that fits the found 3/8" rebar. Consumer's shows iron set on split 2638.65' to 'C7' and 'C5'. We measure 2634.9' to 'C5' and 2647.75' to 'C7'. N-S fence is 9' E. E-W fence is 44' N. Fence Cor. is NNE 45.5'. 3/8" rebar accepted as the best available evidence of the position of the original corner.

C. Description of monument for corner and accessories established to perpetuate locating the position of the corner:

C6 – Drove 4" DNR Alum. Cap on 1" x 5' long galv. iron pipe over top of fd. 3/8" rebar – Up 1.2'.  
 Set Orange Carsonite Post 1' N  
 N50°W 65.11' to chiseled 'X' on face 2" iron pipe (CPC)  
 N37°E 48.79' to set 3/8" x 18" rebar  
 S43°E 54.57' to set ½" x 18" rebar  
 S89°28' 44"W 124.81' (123.86'-CPC) set 2" Alum. Cap on 5/8" x 34" rebar at intersection of E-W ¼ line and W'ly line of Consumer's fee strip.  
 N0° 59'48" W 339.98' (CPC & M) to set 2" Alum. Cap on 5/8" x 34" rebar on Sec. line and deflection point of Consumer fee strip.

Signed by: Craig W. McVean Date: 11/30/2005  
 Surveyor's Michigan License No.: 39088