

LAND CORNER RECORDATION CERTIFICATE

Filing Requirement of Act 74, Mich. PA 1970

For Corners In:
Arenac Located In _____ Corner Code # _____
 (County)

1. Public Land Survey	T	<u>19N</u>	R	<u>3E</u>	<u>C7</u>
	T	_____	R	_____	_____
2. Property Controlling in Section	S	T	R	_____	_____
	S	T	R	_____	_____
3. Miscellaneous Property in Section	S	T	R	_____	_____
	S	T	R	_____	_____


4. Lot No: _____ Recorded Plat: _____

5. Private Claims: _____

I, Craig W. McVean, in a field survey on Oct. 11, 2005 do hereby state that under requirements of PA 74, Michigan PA of 1970, the corner points mentioned in lines 1 and 2 above were in conformance with regulations and rules therefore as required in the current manual of survey instructions of the United States Department of the Interior, Bureau of Land Management or by a decree of a Court of Law and/or that the corner points mentioned in lines 3, 4 and 5 above were in conformance with the rules of the Michigan Board of Land Surveyors or by a Decree of a Court of Law; established, re-established, monumented, recovered, found as expressed below:

NOTE: Not more than 2 corners, all in the same town and range, may be recorded on this certificate.

Register of Deeds Stamp & File Number

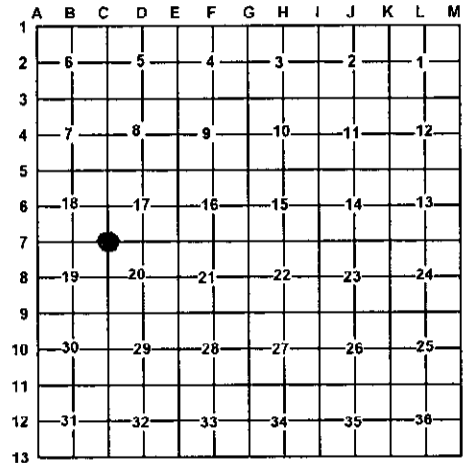

A. Description of original monument and accessories and/or subsequent restoration:

C7 – GLO – Set Post – J. Mullett – 1846
 Spruce 3" N17°W 36 L.
 Tamarack 7" S7°E 58 L.
 - CCC Notes – 1930's – Random E. 80 CH – Set Random Post
 - CPC – Drawing # SF16944 – Sheet 100 – 1968
 Set iron; 8" Tw. Oak S12°E 92.8'
 10" Tw. Pine S30°W 93.8'

B. Description of corner evidence found and/or method applied in restoring or re-establishing corner:

C7 – Sec. Corner to Sec. 17, 18, 19 & 20 – Fd. 3/8" x 18" rebar in agreement with 2 Consumer's Wit's. in swamp. GLO BT's gone. Measured East 305' ± 10' (297' – GLO) to leave swamp and enter pine ridge and measured east 478' ± 3' (495' – GLO) to leave sand ridge enter swamp. Centerline NW-SE RR Grade Rd. is SW'ly 57'. 3/8" rebar per Consumer's drawing accepted as the best available evidence of the position of the original corner.

C. Description of monument for corner and accessories established to perpetuate locating the position of the corner:

C7 – Replaced 3/8" x 18" rebar with 3" Arenac Co. Remon. Brass Cap on 5/8" x 4' long iron rebar.
 Set Orange Carsonite Post 1' N.
 S78°W 41.92' to set N & T in N. side 16" Oak
 S26°W 26.52' to set N & T in NW side 8" R. Pine
 S24°W 94.43' to set N & T in NW side Twin 20" R. Pine (CPC)
 S18°E 93.42' to set N & T in E. side Twin 16" Oak (CPC)
 S65°E 60.63' to set N & T in SW side 4" R. Pine



Signed by: Craig W. McVean
 Surveyor's Michigan License No.: 39088

Date: 11/30/2005