

# LAND CORNER RECORDATION CERTIFICATE

Filing Requirement of Act 74, Mich. PA 1970

For Corners In:  
Arenac Located In \_\_\_\_\_ Corner Code # \_\_\_\_\_  
 (County)



1. Public Land Survey T 19N R 3E E6  
 T \_\_\_\_\_ R \_\_\_\_\_ \_\_\_\_\_  
 2. Property Controlling in Section S \_\_\_\_\_ T \_\_\_\_\_ R \_\_\_\_\_  
 S \_\_\_\_\_ T \_\_\_\_\_ R \_\_\_\_\_  
 3. Miscellaneous Property in Section S \_\_\_\_\_ T \_\_\_\_\_ R \_\_\_\_\_  
 S \_\_\_\_\_ T \_\_\_\_\_ R \_\_\_\_\_

4. Lot No: \_\_\_\_\_ Recorded Plat: \_\_\_\_\_

5. Private Claims: \_\_\_\_\_

I, Craig W. McVean, in a field survey on July 6, 2005 do hereby state that under requirements of PA 74, Michigan PA of 1970, the corner points mentioned in lines 1 and 2 above were in conformance with regulations and rules therefore as required in the current manual of survey instructions of the United States Department of the Interior, Bureau of Land Management or by a decree of a Court of Law and/or that the corner points mentioned in lines 3, 4 and 5 above were in conformance with the rules of the Michigan Board of Land Surveyors or by a Decree of a Court of Law; established, re-established, monumented, recovered, found as expressed below:

**NOTE: Not more than 2 corners, all in the same town and range, may be recorded on this certificate.**

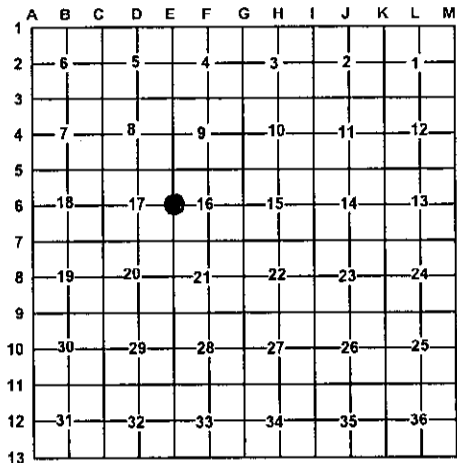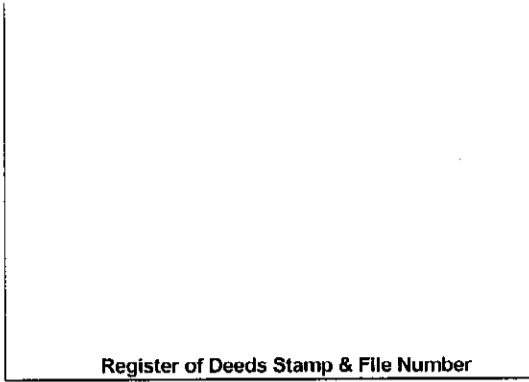

**A. Description of original monument and accessories and/or subsequent restoration:**

- E6 – GLO – Set ¼ Post – J. Mullett – 1846
- W. Pine 14" N66°W 12 L.
- Maple 8" S26°E 42 L.
- CCC Notes – 1930's – S. 40 CH
- Set Random post
- CPC Survey – Drawing #SF16944 – Sheet 101 – 1968
- Corner set
- DNR Surv. Proj #22-93205 – K. J. Ostling – 1984
- Fd. ¾" iron pipe

**B. Description of corner evidence found and/or method applied in restoring or re-establishing corner:**

E6 – ¼ Corner common to Sec. 16 & 17 – Fd. ¾" I.D. iron pipe at end of old road bed to South. Fits Ostling's Survey. No GLO evidence. No evidence of Consumer iron. ¾" iron pipe accepted as the best available evidence of the position of the original corner.

**C. Description of monument for corner and accessories established to perpetuate locating the position of the corner:**

- E6 – Drove stamped 2" Alum. Cap on 5/8" x 4' rebar in fd. ¾" pipe.
- Set Blue Carsonite Post 1' SE
- N85°E 13.75' to set N & T in N. side 12" Cherry scribed 'XBT'
- S14°E 68.95' to set N & T in W. side 12" R. Maple scribed 'XBT'
- S16°W 59.36' to set N & T in E. side 5" R. Maple scribed 'XBT'
- N74°W 44.01' to set N & T in N. side 7" Oak scribed 'XBT'



Signed by: Craig W. McVean  
 Surveyor's Michigan License No.: 39088

Date: 11/30/2005