

# LAND CORNER RECORDATION CERTIFICATE

Filing Requirement of Act 74, Mich. PA 1970

For Corners In: Arenac Located In \_\_\_\_\_ Corner Code # \_\_\_\_\_  
(County)

1. Public Land Survey T 19N R 3E E8  
T \_\_\_\_\_ R \_\_\_\_\_

2. Property Controlling In Section S \_\_\_\_\_ T \_\_\_\_\_ R \_\_\_\_\_  
S \_\_\_\_\_ T \_\_\_\_\_ R \_\_\_\_\_

3. Miscellaneous Property in Section S \_\_\_\_\_ T \_\_\_\_\_ R \_\_\_\_\_  
S \_\_\_\_\_ T \_\_\_\_\_ R \_\_\_\_\_


4. Lot No: \_\_\_\_\_ Recorded Plat: \_\_\_\_\_

5. Private Claims: \_\_\_\_\_

I, Craig W. McVean, in a field survey on Oct. 4, 2005 do hereby state that under requirements of PA 74, Michigan PA of 1970, the corner points mentioned in lines 1 and 2 above were in conformance with regulations and rules therefore as required in the current manual of survey instructions of the United States Department of the Interior, Bureau of Land Management or by a decree of a Court of Law and/or that the corner points mentioned in lines 3, 4 and 5 above were in conformance with the rules of the Michigan Board of Land Surveyors or by a Decree of a Court of Law; established, re-established, monumented, recovered, found as expressed below:

**NOTE: Not more than 2 corners, all in the same town and range, may be recorded on this certificate.**

Register of Deeds Stamp & File Number

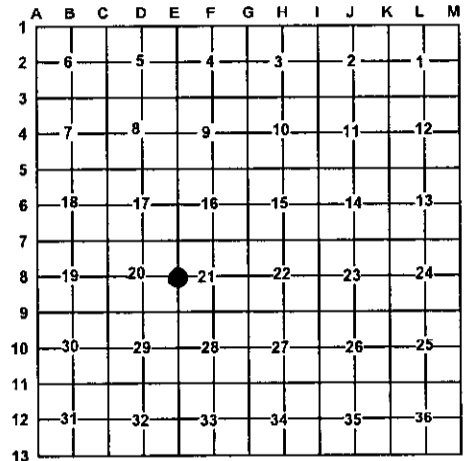

A. Description of original monument and accessories and/or subsequent restoration:

E8 - GLO - Set 1/4 Post - John Mullett - 1846  
W. Pine 12" S7°W 33 L.  
Y. Pine 12" N52°E 7 L.  
- CPC - Drawing # SF 16944 - Sheet 102 - 1967  
Set iron midway between corners N & S.

B. Description of corner evidence found and/or method applied in restoring or re-establishing corner:

E8 - 1/4 Corner common to Sec. 20 & 21 - No GLO evidence. No evidence of Consumer's position. Did find 3/8" rebar in E-W fence but only an apparent random point. Used Consumer's 'T' irons found N & S to reset their position as follows. Fd. 'T' iron at 'E9' on E. line of fee strip and measured N0° 52' 11" W 3197.21' vs. 3197.45' - CPC to found 'T' iron at fee strip deflection point. Thus set 4" DNR Alum. Cap on 1" x 36" galv. iron pipe on line between said 'T' irons single proportion to Consumer's Survey as follows: S. 2635.34' vs. 2635.54' - CPC and N. 561.87' vs. 561.91' - CPC. E-W Fence is 12' N. DNR Mon. accepted as the best available evidence of the position of the original corner.

C. Description of monument for corner and accessories established to perpetuate locating the position of the corner:

E8 - 4" DNR Alum. Cap on 1" x 36" galv. iron pipe  
Set Blue Carsonite Post 1' NE  
S20°E 7.81' to set N & T in W. side 3" R. Pine  
S37°W 34.78' to set N & T in NW side tw. 24" Oak  
N71°E 53.88' to set N & T in NW side 8" Oak scribed 'XBT'  
N14°E 53.94' to set N & T in E. side 13" Oak scribed 'XBT'  
N14°02'E 11.29' to fd. 3/8" rebar



Signed by: Craig W. McVean  
Surveyor's Michigan License No.: 39088

Date: 11/30/2005