

LAND CORNER RECORDATION CERTIFICATE

Filing Requirement of Act 74, Mich. PA 1970

For Corners In:
Arenac Located In _____ Corner Code # _____
 (County)

1. Public Land Survey T 19N R 3E F7
 T _____ R _____ _____
 2. Property Controlling in Section S _____ T _____ R _____
 S _____ T _____ R _____
 3. Miscellaneous Property in Section S _____ T _____ R _____
 S _____ T _____ R _____


4. Lot No: _____ Recorded Plat: _____

5. Private Claims: _____

I, Craig W. McVean, in a field survey on Oct. 11, 2005 do hereby state that under requirements of PA 74, Michigan PA of 1970, the corner points mentioned in lines 1 and 2 above were in conformance with regulations and rules therefore as required in the current manual of survey instructions of the United States Department of the Interior, Bureau of Land Management or by a decree of a Court of Law and/or that the corner points mentioned in lines 3, 4 and 5 above were in conformance with the rules of the Michigan Board of Land Surveyors or by a Decree of a Court of Law; established, re-established, monumented, recovered, found as expressed below:

NOTE: Not more than 2 corners, all in the same town and range, may be recorded on this certificate.

Register of Deeds Stamp & File Number

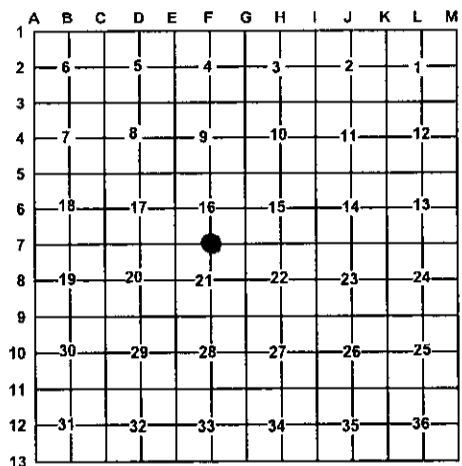

A. Description of original monument and accessories and/or subsequent restoration:

- F7 - GLO - Set 1/4 Post - J. Mullett - 1846
 W. Pine 12" N41°E 38 L.
 Hemlock 10" S14°W 22 L.
- CSR - FB #20, p. 35 - 1921 - Set Cedar post equal dist. & on line between NE & NW Cor. WPS 14" S45°W 1 L. - Rd. Survey.
- CCC Notes - 1930's - Random E. 200 CH
 Set Random post

B. Description of corner evidence found and/or method applied in restoring or re-establishing corner:

F7 - 1/4 Corner common to Sec. 16 & 21 - Found no conclusive GLO or Co. Survey evidence. Set 4" DNR Alum. Cap on 1" x 6' long galv. iron pipe - single proportion to GLO between 'G7' and 'E7'. Centerline of E-W Gravel Road is 28' S. Corner is N. of Rd. because 1921 survey used rejected position for 'G7' that is some 54' S'ly of accepted 1911 position for 'G7'. DNR Mon. accepted as a careful and faithful reestablishment of the position of the original corner.

C. Description of monument for corner and accessories established to perpetuate locating the position of the corner:

- F7 - 4" DNR Alum. Cap on 1" x 6' long galv. iron pipe
 Set Blue Carsonite Post 1' N
 N63°W 58.38' to set N & T in SW side 7" Tamarack scribed 'XBT'
 N2°W 71.96' to set N & T in W. side 6" Tamarack scribed 'XBT'
 N17°E 98.86' to set N & T in NW side 9" Oak scribed 'XBT'
 N71°E 55.78' to set N & T in N. side 8" Oak scribed 'XBT'
 S38°W 93.03' to set N & T in N. side P.P.



Signed by: Craig W. McVean
 Surveyor's Michigan License No.: 39088

Date: 11/30/2005