

LAND CORNER RECORDATION CERTIFICATE

Filing Requirement of Act 74, Mich. PA 1970

For Corners In:
Arenac Located In _____ Corner Code # _____
 (County)


1. Public Land Survey T 19N R 3E F9
 T _____ R _____
 2. Property Controlling in Section S _____ T _____ R _____
 S _____ T _____ R _____
 3. Miscellaneous Property in Section S _____ T _____ R _____
 S _____ T _____ R _____

4. Lot No: _____ Recorded Plat: _____

5. Private Claims: _____

I, Craig W. McVean, in a field survey on Oct. 6, 2005 do hereby state that under requirements of PA 74, Michigan PA of 1970, the corner points mentioned in lines 1 and 2 above were in conformance with regulations and rules therefore as required in the current manual of survey instructions of the United States Department of the Interior, Bureau of Land Management or by a decree of a Court of Law and/or that the corner points mentioned in lines 3, 4 and 5 above were in conformance with the rules of the Michigan Board of Land Surveyors or by a Decree of a Court of Law; established, re-established, monumented, recovered, found as expressed below:

NOTE: Not more than 2 corners, all in the same town and range, may be recorded on this certificate.

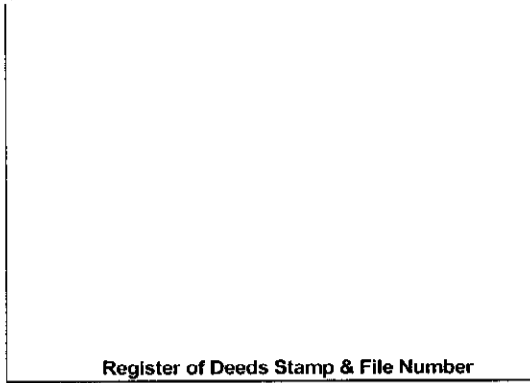

	A	B	C	D	E	F	G	H	I	J	K	L	M
1													
2	6		5		4		3		2		1		
3													
4	7		8		9		10		11		12		
5													
6	18		17		16		15		14		13		
7													
8	19		20		21		22		23		24		
9						●							
10	30		29		28		27		26		25		
11													
12	31		32		33		34		35		36		
13													

A. Description of original monument and accessories and/or subsequent restoration:

F9 – GLO – Set ¼ Post – J. Mullett – 1846
 W. Pine 6" N46°W 13 L.
 Cedar 10" S48°E 27 L.

B. Description of corner evidence found and/or method applied in restoring or re-establishing corner:

F9 – ¼ Corner common to Sec. 21 & 28 – No GLO evidence. Dug in centerline of 2-track opposite fence S. but found no evidence of corner. Set 3" Arenac Co. Remon. Brass Cap on 5/8" x 34" rebar by single proportion to GLO between 'E9' and 'G9'. Centerline of E-W 2-track is 1' ± S. Fence Cor. W & S is 27' S. Measured E 300'± 15' (336' – GLO) to edge of swamp NW – SE. Arenac Co. Mon. accepted as a careful and faithful reestablishment of the position of the original corner.

C. Description of monument for corner and accessories established to perpetuate locating the position of the corner:

F9 – 3" Arenac Co. Remon. Brass Cap on 5/8" x 34" rebar w/ coffee can w/ concrete around cap – Down 0.7'
 N2°E 9.79' to set N & T in E. side 8" Oak
 N62°E 20.45' to set N & T in SE side 13" Oak
 S28°E 30.10' to set N & T in SW side 10" Oak
 S45°W 42.80' to set N & T in NW side 9" Oak



Signed by: Craig W. McVean Date: 11/30/2005
 Surveyor's Michigan License No.: 39088