

LAND CORNER RECORDATION CERTIFICATE

Filing Requirement of Act 74, Mich. PA 1970

For Corners In:
Arenac Located In _____ Corner Code # _____
 (County)

1. Public Land Survey	T	<u>19N</u>	R	<u>3E</u>	<u>G9</u>
	T	_____	R	_____	_____
2. Property Controlling in Section	S	_____	T	_____	_____
	S	_____	T	_____	_____
3. Miscellaneous Property in Section	S	_____	T	_____	_____
	S	_____	T	_____	_____


4. Lot No: _____ Recorded Plat: _____

5. Private Claims: _____

I, Craig W. McVean, in a field survey on Sept. 26, 2005 do hereby state that under requirements of PA 74, Michigan PA of 1970, the corner points mentioned in lines 1 and 2 above were in conformance with regulations and rules therefore as required in the current manual of survey instructions of the United States Department of the Interior, Bureau of Land Management or by a decree of a Court of Law and/or that the corner points mentioned in lines 3, 4 and 5 above were in conformance with the rules of the Michigan Board of Land Surveyors or by a Decree of a Court of Law; established, re-established, monumented, recovered, found as expressed below:

NOTE: Not more than 2 corners, all in the same town and range, may be recorded on this certificate.

Register of Deeds Stamp & File Number

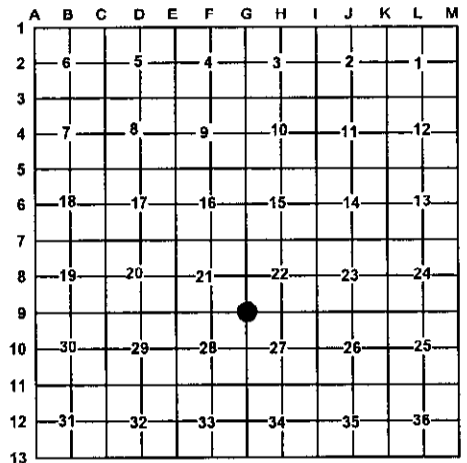

A. Description of original monument and accessories and/or subsequent restoration:

G9 - GLO - Set Post - J. Mullett - 1846
 Beech 10" N32°E 22 L.
 Sugar 8" S9°W 31 L.
 - S. J. E. Lucas - Survey Map - 1914
 Substantial corner.



B. Description of corner evidence found and/or method applied in restoring or re-establishing corner:

G9 - Sec. Cor. common to Sec. 21, 22, 27 & 28 - Fd. 3/8" rebar in Gravel Rd. intersection. 4± W. of N-S centerline. In line with centerline Gravel to E. Excavated under 3/8" x 18" rebar and find 1" sq. axle shaft - Down 1.7' about 0.3' to SE. Also a large chunk of iron (probably ax head) alongside axle shaft. Accepted axle shaft as the best available evidence of the position of the original corner.

C. Description of monument for corner and accessories established to perpetuate locating the position of the corner:

G9 - Raised 1" axle shaft with ³/₃ Arenac Co. Remon. Brass Cap on 5/8" x 0.8' long rebar with 4" x 1.4' long PVC filled with conc. around cap and irons.
 N45°W 42.18' to fd. Apex N & T in NE side 25" R. Maple
 S9°W 147.85' to set N & T in E. side 36" Walnut
 S54°E 109.61' to set Mag nail & tag in SW side PP
 N81°E 164.12' to set N & T in N. side 34" Basswood
 N69°W 149.26' to SE Cor. Blk. Hse. Foundation.

Signed by: Craig W. McVean
 Surveyor's Michigan License No.: 39088

Date: 11/30/2005