

# LAND CORNER RECORDATION CERTIFICATE

Filing Requirement of Act 74, Mich. PA 1970

For Corners In:  
Arenac Located In \_\_\_\_\_ Corner Code # \_\_\_\_\_  
 (County)

1. Public Land Survey	T	19N	R	3E	H7
	T	_____	R	_____	_____
2. Property Controlling in Section	S	T	R	_____	_____
	S	T	R	_____	_____
3. Miscellaneous Property in Section	S	T	R	_____	_____
	S	T	R	_____	_____


4. Lot No: \_\_\_\_\_ Recorded Plat: \_\_\_\_\_

5. Private Claims: \_\_\_\_\_

I, Craig W. McVean, in a field survey on Oct. 10, 2005 do hereby state that under requirements of PA 74, Michigan PA of 1970, the corner points mentioned in lines 1 and 2 above were in conformance with regulations and rules therefore as required in the current manual of survey instructions of the United States Department of the Interior, Bureau of Land Management or by a decree of a Court of Law and/or that the corner points mentioned in lines 3, 4 and 5 above were in conformance with the rules of the Michigan Board of Land Surveyors or by a Decree of a Court of Law; established, re-established, monumented, recovered, found as expressed below:

**NOTE: Not more than 2 corners, all in the same town and range, may be recorded on this certificate.**

Register of Deeds Stamp & File Number

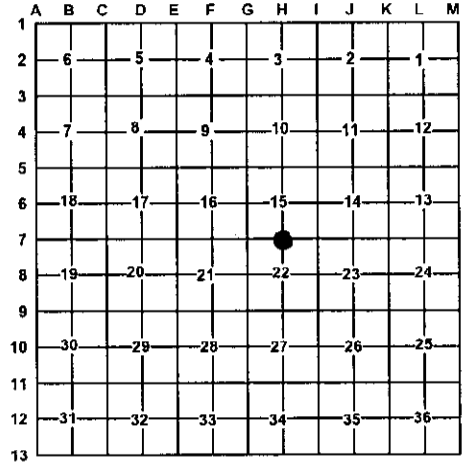

A. Description of original monument and accessories and/or subsequent restoration:

- H7 - GLO - Set 1/4 Post - J. Mullett - 1846  
 W. Pine 6" N69°E 20 L.  
 W. Pine 10" S31°W 13 L.  
 - CSR - FB # '1A'; P. 19 - 1911 - Corrected 1/4 Post 16 L. E and 31 L. N. of Lucas post and 67 L. S. and 9 L. W. of my random.  
 - CSR - FB #20, p. 34 - 1921 - Set Sq. cedar post W/ cast iron urn off top of stove. Phone N21½°E 45¼; Fence Post 39 1/2  
 - CCC Notes - 1930's - E. Random 280 CH. - Set Random post  
 - Bill Woods notes - Set 3/4" iron pipe. - 1997

B. Description of corner evidence found and/or method applied in restoring or re-establishing corner:

H7 - ¼ Corner common to Sec. 15 & 22 - No conclusive evidence of Co. Survey monuments. No GLO evidence. Thus set 4" DNR Alum. Cap on 1" x 36" galv. iron pipe midway and on-line between recovered 1911 position at 'I-7' and reest. 1911 position at 'G7' as noted by 1911 CSR notes. Distance E & W is 2643.21' - M vs. 2645.94' - R. - 1911. Centerline of E-W Gravel Road is 19.5' S. Old down fence wire N is 8'± W. DNR Mon. accepted as the best available evidence of the position of the original corner.

- Ref. Pt. - Found bent ¾" iron pipe per Woods is S15°47'E 26.91' from 'H7'. This pipe set midway and on line between rejected positions at 'G7' and 'I-7'. ¾" pipe not utilized as 'H7' in this survey.

C. Description of monument for corner and accessories established to perpetuate locating the position of the corner:

H7 - 4" DNR Alum. Cap on 1" x 36" Galv. iron pipe.  
 Set Blue Carsonite Post 1' N.  
 N36°E 49.66' to set N & T in SE side 7" W. Pine  
 N78°E 56.59' to set N & T in S side 6" J. Pine  
 N32°W 12.26' to set N & T in SW side 6" Elm  
 S17°W 56.73' to Fd. N & T in E. side 8" R. Maple  
 S18°E 57.12' to set N & T in W. side 7" R. Maple  
 S15°47' E. 26.91' to fd. ¾" iron pipe - Ref. Pt.



Signed by: Craig W. McVean Date: 11/30/2005  
 Surveyor's Michigan License No.: 39088