

LAND CORNER RECORDATION CERTIFICATE

Filing Requirement of Act 74, Mich. PA 1970

For Corners In:
Arenac Located In _____ Corner Code # _____
 (County)



1. Public Land Survey	T	<u>19N</u>	R	<u>3E</u>	<u>I-6</u>
	T	_____	R	_____	_____
2. Property Controlling in Section	S	_____	T	_____	_____
	S	_____	T	_____	_____
3. Miscellaneous Property in Section	S	_____	T	_____	_____
	S	_____	T	_____	_____

4. Lot No: _____ Recorded Plat: _____

5. Private Claims: _____

I, Craig W. McVean, in a field survey on Oct. 4, 2005 do hereby state that under requirements of PA 74, Michigan PA of 1970, the corner points mentioned in lines 1 and 2 above were in conformance with regulations and rules therefore as required in the current manual of survey instructions of the United States Department of the Interior, Bureau of Land Management or by a decree of a Court of Law and/or that the corner points mentioned in lines 3, 4 and 5 above were in conformance with the rules of the Michigan Board of Land Surveyors or by a Decree of a Court of Law; established, re-established, monumented, recovered, found as expressed below:

NOTE: Not more than 2 corners, all in the same town and range, may be recorded on this certificate.

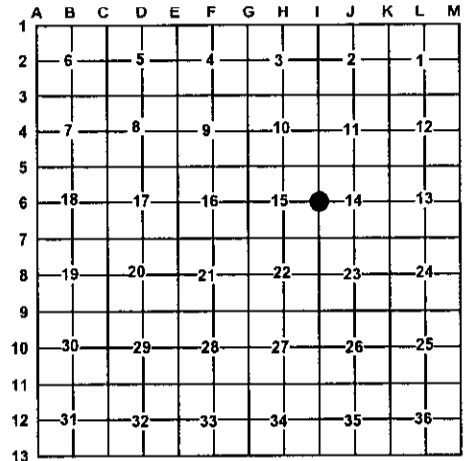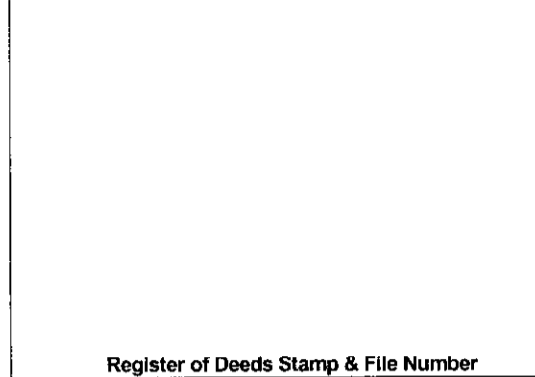

A. Description of original monument and accessories and/or subsequent restoration:

- I-6 – Set ¼ post – J. Mullett – 1846
 Hemlock 10" S51°W 15 L.
 Hemlock 14" N18°E 9 L.
- CSR – FB '1A', p. 15 – 1911. Fd. old wood post and marked a W. Pine 22" N49°W 76 ¾
- Rec. Sur. – L. 1, p. 186 – J. Campbell – 1975
 Set ½" rod. S30°E F. C. 21.2';
 S50°W 12" Poplar 34.36'
- LCRC – L. 3, p. 145 – W. J. Riggs – 2004
 Set ½" rebar and cap
 S50°W 34.8' ± Fd. imbedded nail in Pop.; S30°E 22' ± Fd.
 Nail in F.C.; S45°E 23.9' – Fence post; S45°W 35.49' –
 13" Poplar; N45°E 39.67' – 8" Poplar ; N45°W 40.71' –
 10" Poplar

B. Description of corner evidence found and/or method applied in restoring or re-establishing corner:

- I-6 – ¼ Corner common to Sec. 14 & 15 – No evidence GLO or CSR BT's. Excavated 3.5'± wide x 9' long x 1.5' deep trench in E-W gravel road from fence line S and to West searching for evidence stake noted by Co. Survey record. Found nothing conclusive. Thus set 3" Arenac Co. Remon. Brass Cap on 5/8" x 34" rebar by extending E-W ¼ line from 'K6' through 'J6' to West for latitude and proportion to 1911 distances E & W to recovered 1911 monuments at 'G6' and 'J6' as follows: 2636.05' – M. vs. 2637.36' – R. to 'J6' and 5285.46' – M. vs. 5288.1' – R. to 'G6'. Fence S. is 6'± E. Arenac Co. Mon. accepted as the best available evidence of the position of the original corner.
- Ref. Pt. – Found ½" rebar per W. J. Riggs at Campbell position is S83°47'W 7.82'. Campbell established this position by doubling line and distance West from 'K6' through 'J6' per interpretation of his survey. Doesn't agree with 1911 CSR distances. ½" rebar not utilized as 'I-6' in this survey.

C. Description of monument for corner and accessories established to perpetuate locating the position of the corner:

- I-6 – 3" Arenac Co. Remon. Brass Cap on 5/8" x 34" rebar with 4" x 1" PVC w/ concrete around cap – Down 0.5'±.
 North 33' to set Blue Carsonite Post with loc. tag.
 N26°E 31.24' to set N & T in NW side 7" Oak scribed 'XBT'
 N22°W 35.25' to set N & T in NW side 12" R. Maple scribed 'XBT'
 S3°W 44.81' to set N & T in E. side 8" R. Maple
 S42°W 59.77' to set N & T in SE side 8" Oak
 S83°47'W 7.82 to Fd. ½" rebar – Ref. Pt.



Signed by: Craig W. McVean Date: 11/30/2005
 Surveyor's Michigan License No.: 39088