

# LAND CORNER RECORDATION CERTIFICATE

Filing Requirement of Act 74, Mich. PA 1970

For Corners In:			
<u>Arenac</u>	Located In	Corner Code #	
(County)			
1. Public Land Survey	T <u>19N</u> R <u>3E</u>	<u>B3</u>	
	T _____ R _____	_____	_____
2. Property Controlling in Section	S _____ T _____ R _____	_____	_____
	S _____ T _____ R _____	_____	_____
3. Miscellaneous Property in Section	S _____ T _____ R _____	_____	_____
	S _____ T _____ R _____	_____	_____


Register of Deeds Stamp & File Number

4. Lot No: \_\_\_\_\_ Recorded Plat: \_\_\_\_\_

5. Private Claims: \_\_\_\_\_

I, Craig W. McVean, in a field survey on Feb. 15, 2005 do hereby state that under requirements of PA 74, Michigan PA of 1970, the corner points mentioned in lines 1 and 2 above were in conformance with regulations and rules therefore as required in the current manual of survey instructions of the United States Department of the Interior, Bureau of Land Management or by a decree of a Court of Law and/or that the corner points mentioned in lines 3, 4 and 5 above were in conformance with the rules of the Michigan Board of Land Surveyors or by a Decree of a Court of Law; established, re-established, monumented, recovered, found as expressed below:

**NOTE: Not more than 2 corners, all in the same town and range, may be recorded on this certificate.**

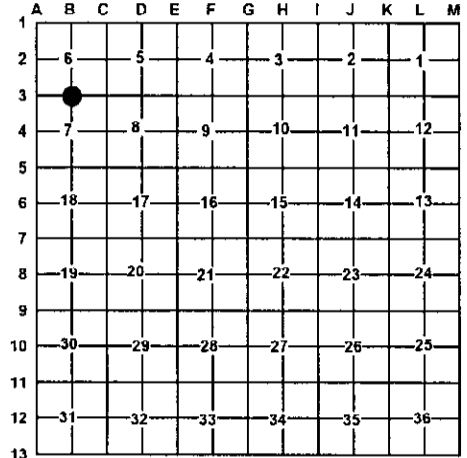

**A. Description of original monument and accessories and/or subsequent restoration:**

- B3 – GLO – Set ¼ Post – J. Mullett – 1846  
 Y. Pine 12" N43°E 28 L.  
 W. Pine 20" S65°W 15 L.  
 - CCC – 1930's – Random Line – Nothing noted  
 - CPC – 1968 – Drawing # SF16944 – Sheet 99  
 Calculated position shown.

**B. Description of corner evidence found and/or method applied in restoring or re-establishing corner:**

B3 – ¼ Corner common to Sec. 6 & 7 – Searched for evidence of corner. Number of pine stp's in area but nothing conclusive. Set 4" DNR Alum. Cap on 1" x 36" Galv. iron pipe by single proportion between Consumer's fd. 'C3' position and CCC's fd. 'A3' position. DNR Monument is 9' ± Westerly of Consumer's calculated position. DNR Mon. accepted as a careful and faithful re-establishment of the position of the original corner.

**C. Description of monument for corner and accessories established to perpetuate locating the position of the corner:**

B3 – 4" DNR Alum. Cap on 1" x 36" Galv. iron pipe.  
 Set Blue Carsonite Post 1' N  
 N26°E 77.98' to set N & T in W. side 8" Tamarack scribed 'XBT'  
 N80°E 49.24' to set N & T in N side 8" Tamarack scribed 'XBT'  
 S58°E 41.36' to set N & T in NW side 6" Tamarack scribed 'XBT'  
 N50°W 37.54' to set N & T in NE side 10' Tamarack scribed 'XBT'



Signed by: Craig W. McVean Date: 9/22/2005  
 Surveyor's Michigan License No.: 39088