


LAND CORNER RECORDATION CERTIFICATE


Filing Requirement of Act 74, Mich. PA 1970

For Corners In:			
Arenac	Located In	Corner Code #	
(County)			
1. Public Land Survey	T 19N R 3E	D5	
	T _____ R _____	_____	_____
2. Property Controlling in Section	S _____ T _____ R _____	_____	_____
	S _____ T _____ R _____	_____	_____
3. Miscellaneous Property in Section	S _____ T _____ R _____	_____	_____
	S _____ T _____ R _____	_____	_____
4. Lot No: _____	Recorded Plat: _____		
5. Private Claims: _____			

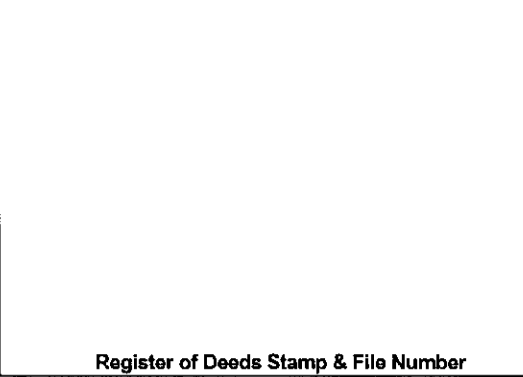

I, Craig W. McVean, in a field survey on Feb. 16, 2005 do hereby state that under requirements of PA 74, Michigan PA of 1970, the corner points mentioned in lines 1 and 2 above were in conformance with regulations and rules therefore as required in the current manual of survey instructions of the United States Department of the Interior, Bureau of Land Management or by a decree of a Court of Law and/or that the corner points mentioned in lines 3, 4 and 5 above were in conformance with the rules of the Michigan Board of Land Surveyors or by a Decree of a Court of Law; established, re-established, monumented, recovered, found as expressed below:

NOTE: Not more than 2 corners, all in the same town and range, may be recorded on this certificate.

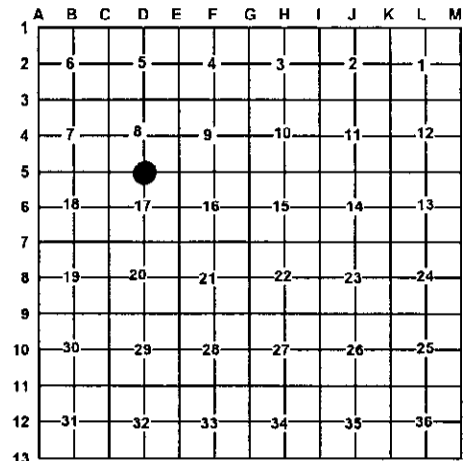

A. Description of original monument and accessories and/or subsequent restoration:

- D5 – GLO – 8" Tamarack for corner – J. Mullett – 1846
- Co. Sur. Map – S. J. E. Lucas – 1914
- gal. iron pipe 1 1/4" x 6' for qr. corner.
- CCC Notes – 1930's – Random E. 120.00 CH.
- Fd. iron post 5 1/2" N. and 60 W. of Random
- CPC Survey and Notes – Drawing # SF 16944 – Sheet 100
- 1968; Corner set. Notes shows fd. 1 1/2" iron pipe – Not used as corner.

B. Description of corner evidence found and/or method applied in restoring or re-establishing corner:

D5 – 1/4 Corner common to Sec. 8 & 17 – No evidence of Lucas pipe or Consumer's iron. Position falls on N. edge of ditch. Fd. 1 1/2" (1 3/4" O.D.) pipe per Consumers notes (not corner) but too far N & W to be correct N66°W 39.5' of SP position. All evidence obliterated by ditching. Thus set 3" Arenac Co. Brass Cap on 5/8" x 5' long re-bar midway (2640.77' vs. 2640' – Lucas both ways) and on line between fd. 'C5' and restored 'E5'. This fits position noted by Lucas Map. Monument on N. edge of E-W drain. Arenac Co. Monument accepted as a careful and faithful re-establishment of the position of the original corner.

C. Description of monument for corner and accessories established to perpetuate locating the position of the corner:

- D5 – 3" Arenac Co. Remon. Brass Cap on 5/8" x 5' long iron rebar – Add cobble stones around.
- Set Orange Carsonite Post 1' N.
- N66°W 39.50' to fd. 1 3/4" O.D. iron pipe – Up 2.5'
- N7°W 40.58' to set N & T in E. side 8" Oak
- N35°E 69.88' to set N & T in NW side 12" Oak
- S67°E 63.15' to set N & T in N side 4" Cherry



Signed by: Craig W. McVean
 Surveyor's Michigan License No.: 39088

Date: 9/22/2005