

LAND CORNER RECORDATION CERTIFICATE

Filing Requirement of Act 74, Mich. PA 1970

For Corners In:			
<u>Arenac</u>	Located In	Corner Code #	
(County)			
1. Public Land Survey	T <u>19N</u> R <u>3E</u>	<u>E5</u>	
	T _____ R _____	_____	_____
2. Property Controlling in Section	S _____ T _____ R _____	_____	_____
	S _____ T _____ R _____	_____	_____
3. Miscellaneous Property in Section	S _____ T _____ R _____	_____	_____
	S _____ T _____ R _____	_____	_____


4. Lot No: _____ Recorded Plat: _____

5. Private Claims: _____

I, Craig W. McVean, in a field survey on Feb. 16, 2005 do hereby state that under requirements of PA 74, Michigan PA of 1970, the corner points mentioned in lines 1 and 2 above were in conformance with regulations and rules therefore as required in the current manual of survey instructions of the United States Department of the Interior, Bureau of Land Management or by a decree of a Court of Law and/or that the corner points mentioned in lines 3, 4 and 5 above were in conformance with the rules of the Michigan Board of Land Surveyors or by a Decree of a Court of Law; established, re-established, monumented, recovered, found as expressed below:

NOTE: Not more than 2 corners, all in the same town and range, may be recorded on this certificate.

Register of Deeds Stamp & File Number

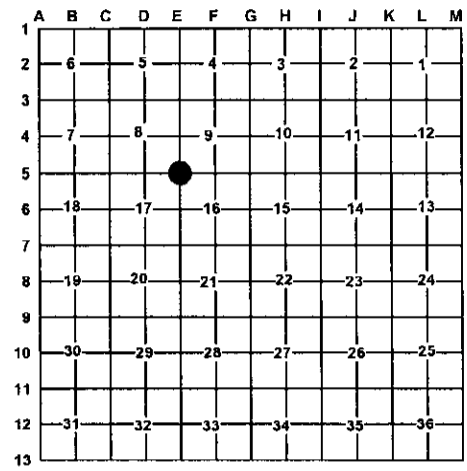

A. Description of original monument and accessories and/or subsequent restoration:

- E5 - GLO - Set Post - J. Mullett - 1846
- Tamarack 8" N22°E 13 L.
- Tamarack 8" S33°W 19 L.
- Co. Sur. Map - S. J. E. Lucas - 1914
- Fd. very substantial evidence of the original corner here. Excavated out point of an old stake, also fd. body of an old stake lying in a horizontal position 12" beneath the surface. Set 1 1/4" x 6' gal. iron pipe here to perpetuate this corner.
- CCC Notes - 1930's - Random E 160.00 CH.
- Fd. iron post 61 W. and 11 L. S. of random.
- CPC Notes (Edmands Eng.) - Fd. 1 1/2" pipe.
- 3" square carved stake 12" high - 1968 ±

B. Description of corner evidence found and/or method applied in restoring or re-establishing corner:

E5 - Sec. Corner common to Sec. 8, 9, 16 & 17 - No evidence of pipes noted by Lucas, CCC or Consumers. Large ditches in area with open fields. All evidence obliterated. Distance between 'C5' and 'F5' is 7922.3' vs. 7920' Lucas. Thus set 3" Arenac Co. Brass Cap on 5/8" x 4' long rebar by extension of line from 'G5' through 'F5' (both Lucas positions) Westerly 2640.76' (grid) per position noted by Lucas Survey Map. Monument falls on N. bank of E-W ditch. Centerline ditch south is 88' W. Lucas noted having original corner at this position. Arenac Co. Monument accepted as a careful and faithful perpetuation of the position of the original corner.

C. Description of monument for corner and accessories established to perpetuate locating the position of the corner:

- E5 - 3" Arenac Co. Brass Cap on 5/8" x 4' long iron rebar
- Set Orange Carsonite Post 1' N.
- S87°W 40.05' to top fd. 1 1/4" O.D. iron pipe - Up 3'
- S52°W 63.50' to base fd. 2" I.D. anchor pipe - Up 2.5'
- N35°E 51.63' to set 1/2" x 24" rebar in field
- N31°W 57.96' to set 1/2" x 18" rebar in field



Signed by: Craig W. McVean
 Surveyor's Michigan License No.: 39088

Date: 9/22/2005