

## LAND CORNER RECORDATION CERTIFICATE

Filing Requirement of Act 74, Mich. PA 1970



For Corners In:			
<u>Arenac</u>	Located In	Corner Code #	
(County)			
1. Public Land Survey	T <u>19N</u> R <u>3E</u>	<u>F3</u>	
	T _____ R _____	_____	_____
2. Property Controlling in Section	S _____ T _____ R _____	_____	_____
	S _____ T _____ R _____	_____	_____
3. Miscellaneous Property in Section	S _____ T _____ R _____	_____	_____
	S _____ T _____ R _____	_____	_____

4. Lot No: \_\_\_\_\_ Recorded Plat: \_\_\_\_\_

5. Private Claims: \_\_\_\_\_

I, Craig W. McVean, in a field survey on July 6, 2005 do hereby state that under requirements of PA 74, Michigan PA of 1970, the corner points mentioned in lines 1 and 2 above were in conformance with regulations and rules therefore as required in the current manual of survey instructions of the United States Department of the Interior, Bureau of Land Management or by a decree of a Court of Law and/or that the corner points mentioned in lines 3, 4 and 5 above were in conformance with the rules of the Michigan Board of Land Surveyors or by a Decree of a Court of Law; established, re-established, monumented, recovered, found as expressed below:

**NOTE: Not more than 2 corners, all in the same town and range, may be recorded on this certificate.**

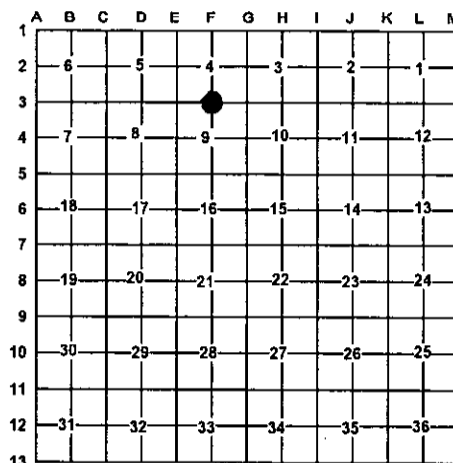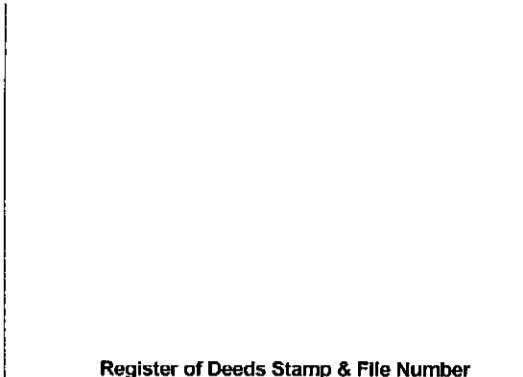

**A. Description of original monument and accessories and/or subsequent restoration:**

- F3 - Set 1/4 Sec. Post - J. Mullett - 1846
- W. Pine 10" N76°E 15 L.
- Tamarack 6" S61°W 12 L.
- CCC Notes - 1930's - East 200+00 CH. - Set Random Post in swamp
- MDOT - 1965 - No evidence of corner.

**B. Description of corner evidence found and/or method applied in restoring or re-establishing corner:**

- F3 - 1/4 Corner common to Sec. 4 & 9 - No conclusive GLO evidence found. Set 1" x 5' long galv. iron pipe with stamped 4" DNR Aluminum cap by single proposition to GLO between found MDOT position at 'G3' and reestablished position at 'E3'. Falls in open swampy area. DNR monument accepted as a careful and faithful reestablishment of the position of the original corner.

**C. Description of monument for corner and accessories established to perpetuate locating the position of the corner:**

- F3 - 4" Aluminum DNR cap on 1" x 5' long galv. iron pipe
- S58°W 45.55' to set 2' long 'T' iron
- S24°E 45.55' to set 1/2" x 18" rerod
- N58°E 45.72' to set 3/8" x 18" rerod
- N32°W 42.18' to set 1" x 14" iron rod
- Set Blue Carsonite Post 1' North



Signed by: Craig W. McVean  
 Surveyor's Michigan License No.: 39088

Date: 9/22/2005