


LAND CORNER RECORDATION CERTIFICATE


Filing Requirement of Act 74, Mich. PA 1970

For Corners In:			
<u>Arenac</u>	Located In	Corner Code #	
(County)			
1. Public Land Survey	T <u>19N</u> R <u>3E</u>	<u>G3</u>	
	T _____ R _____	_____	_____
2. Property Controlling in Section	S _____ T _____ R _____	_____	_____
	S _____ T _____ R _____	_____	_____
3. Miscellaneous Property in Section	S _____ T _____ R _____	_____	_____
	S _____ T _____ R _____	_____	_____
4. Lot No: _____	Recorded Plat: _____		
5. Private Claims: _____			

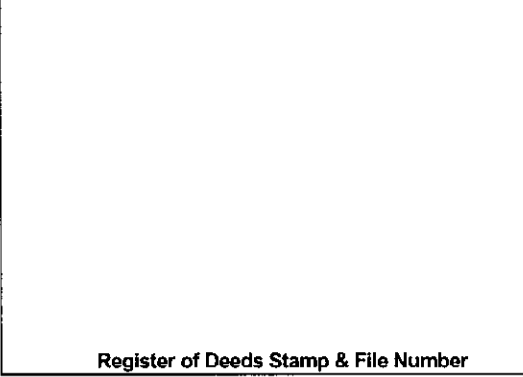

I, Craig W. McVean, in a field survey on March 22, 2005 do hereby state that under requirements of PA 74, Michigan PA of 1970, the corner points mentioned in lines 1 and 2 above were in conformance with regulations and rules therefore as required in the current manual of survey instructions of the United States Department of the Interior, Bureau of Land Management or by a decree of a Court of Law and/or that the corner points mentioned in lines 3, 4 and 5 above were in conformance with the rules of the Michigan Board of Land Surveyors or by a Decree of a Court of Law; established, re-established, monumented, recovered, found as expressed below:

NOTE: Not more than 2 corners, all in the same town and range, may be recorded on this certificate.

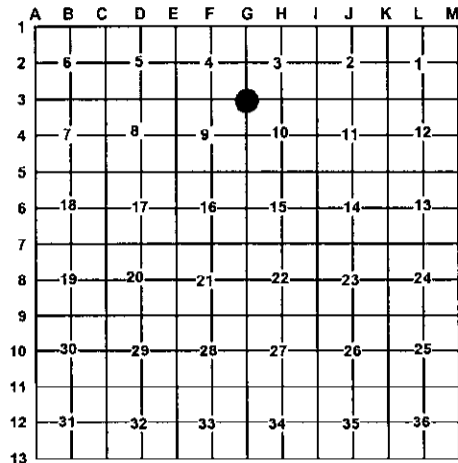

A. Description of original monument and accessories and/or subsequent restoration:

G3 – GLO – Set Post – J. Mullett – 1846
 Hemlock 12" N72°E 20 L.
 Hemlock 14" S41°W 11 L.
 - MDOT Wit. Card – C. F. Roser - 1965
 (LCRC L. 1, p. 223 – 1984) Set 2" pipe; 6' long with
 20" above ground. Marked cedar guard post. This corner
 was set by single proportion between Sec. Cor. One mile
 N & S. No evidence of corners or occupancy a mile E or W.
 Quarter corners one half mile N, S and E not set by this
 survey. 13" W. Birch N55°E 70.13'; 13" Pine (W) Due E.
 257.31'; 20" W. Pine S40°E 304.44';
 7" Poplar S15°W 31.28'

B. Description of corner evidence found and/or method applied in restoring or re-establishing corner:

G3 – Sec. Corner common to Sec. 3, 4, 9, & 10 – Fd. 2" iron pipe – Up 1' ± per MDOT. MDOT Witnesses gone except for large W. Pine to SE (304.44' – R) but couldn't check distance due to thick sapling growth. 2" Pipe fits MDOT's survey dimensions N & S. NW-SE 2-track is N52°E 158'. 2" pipe accepted as the best available evidence of the position of the original corner.

C. Description of monument for corner and accessories established to perpetuate locating the position of the corner:

G3 – Drove stamped 2" Alum. Cap on 5/8" x 5' iron rebar into fd. 2" iron pipe.
 Set Blue Carsonite Post 1' N
 S40°W 56.54' to set N & T in SE side 17" Oak scribed 'XBT'
 N45°E 40.89' to set N & T in W side Tw. 6" Cherry scribed 'XBT'
 N10°W 33.84' to set N & T in E side 3" Oak
 N80°E 32.24' to set N & T in NW side 3" Oak



Signed by: Craig W. McVean
 Surveyor's Michigan License No.: 39088

Date: 9/22/2005