


LAND CORNER RECORDATION CERTIFICATE


Filing Requirement of Act 74, Mich. PA 1970

For Corners In: <u>Arenac</u> (County)	Located In T <u>19N</u> R <u>3E</u>	Corner Code # <u>G4</u>
1. Public Land Survey	T _____ R _____	_____
2. Property Controlling in Section	S _____ T _____ R _____	_____
3. Miscellaneous Property in Section	S _____ T _____ R _____	_____
4. Lot No: _____	Recorded Plat: _____	
5. Private Claims: _____		

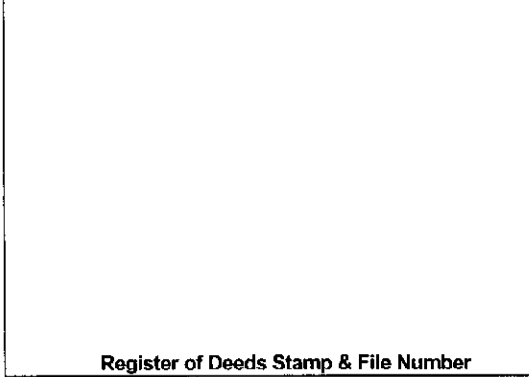

I, Craig W. McVean, in a field survey on Sept. 14, 2005 do hereby state that under requirements of PA 74, Michigan PA of 1970, the corner points mentioned in lines 1 and 2 above were in conformance with regulations and rules therefore as required in the current manual of survey instructions of the United States Department of the Interior, Bureau of Land Management or by a decree of a Court of Law and/or that the corner points mentioned in lines 3, 4 and 5 above were in conformance with the rules of the Michigan Board of Land Surveyors or by a Decree of a Court of Law; established, re-established, monumented, recovered, found as expressed below:

NOTE: Not more than 2 corners, all in the same town and range, may be recorded on this certificate.

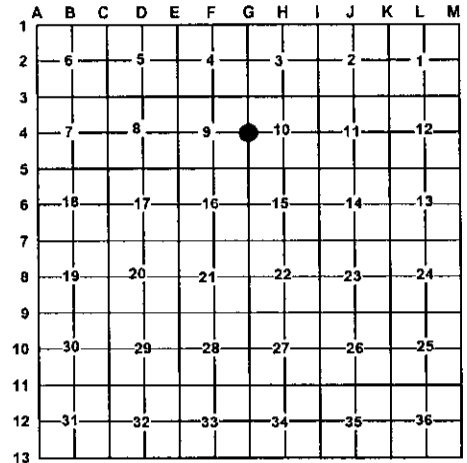

A. Description of original monument and accessories and/or subsequent restoration:

- G4 - GLO - Set 1/4 Post - J. Mullett
- W. Pine 10" S45°E 86 L.
- W. Pine 8" N75°E 170 L.
- CSR - FB # 1A, p. 19 - 1911 - Fd. ogl. wit.
- S 40.44 to 'G5'. Set wood post and 7/8" round iron rod - 4' long.
- MDOT - 1965 - Didn't find. Swamp and fence ties - Working Drawing shows calc. SP position.

B. Description of corner evidence found and/or method applied in restoring or re-establishing corner:

G4 - 1/4 Corner common to Sec. 9 & 10 - Per 1911 'G5' position (33' N. of accepted 1914 - 'G5' position) and Co. Survey Record notes searched 2702' N. of 'G5' but nothing found. Search in swamp at position 2704' N. (79' N. of SP position) and 4' W. of 'G5' on line with 'G3' per MDOT working drawing. Dug here but no evidence of fence noted by MDOT or any iron or wood stake per Co. Sur. Record. Search large area in swamp for iron noted by CSR but found nothing. No evidence of GLO BT's. The distance across the swamp N-S is 645'± (645' - MDOT, 594' - GLO). Don't feel GLO Topo calls are reliable enough to use to reset corner. Thus set 4" DNR Alum. Cap on 1" x 4' long galv. iron pipe by single proportion to GLO (2625.29' - M (2640' - GLO) - N & S between 1914 'G5' position and MDOT 'G3' position. Edge of swamp S. is 120'±3' (165' - GLO). Edge of swamp N. is 525'±5' (429' - GLO). DNR Mon. accepted as a careful and faithful re-establishment of the position of the original corner.

C. Description of monument for corner and accessories established to perpetuate locating the position of the corner:

- G4 - 4" DNR Alum. Cap on 1" x 4' long galv. iron pipe - Up 0.8'
- Set Blue Carsonite Post 1' N.
- N33°W 33.63' to set 1/2" x 1.3' long iron rod
- S34°W 48.79' to set 1/2" x 18" long iron rebar
- N77°E 38.31' to set N & T in S. side 8" Oak scribed 'XBT'
- S68°E 74.33' to set N & T in N. side 24" W. Oak scribed 'XBT'



Signed by: Craig W. McVean
 Surveyor's Michigan License No.: 39088

Date: 9/22/2005