

# LAND CORNER RECORDATION CERTIFICATE

Filing Requirement of Act 74, Mich. PA 1970



For Corners In:			
Arenac	Located In	Corner Code #	
(County)			
1. Public Land Survey	T <u>19N</u> R <u>3E</u>	<u>I-5</u>	
	T _____ R _____	_____	_____
2. Property Controlling in Section	S _____ T _____ R _____	_____	_____
	S _____ T _____ R _____	_____	_____
3. Miscellaneous Property in Section	S _____ T _____ R _____	_____	_____
	S _____ T _____ R _____	_____	_____

4. Lot No: \_\_\_\_\_ Recorded Plat: \_\_\_\_\_

5. Private Claims: \_\_\_\_\_

I, Craig W. McVean, in a field survey on July 5, 2005 do hereby state that under requirements of PA 74, Michigan PA of 1970, the corner points mentioned in lines 1 and 2 above were in conformance with regulations and rules therefore as required in the current manual of survey instructions of the United States Department of the Interior, Bureau of Land Management or by a decree of a Court of Law and/or that the corner points mentioned in lines 3, 4 and 5 above were in conformance with the rules of the Michigan Board of Land Surveyors or by a Decree of a Court of Law, established, re-established, monumented, recovered, found as expressed below:

**NOTE: Not more than 2 corners, all in the same town and range, may be recorded on this certificate.**

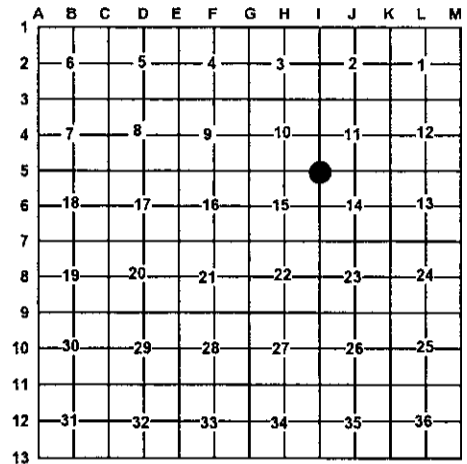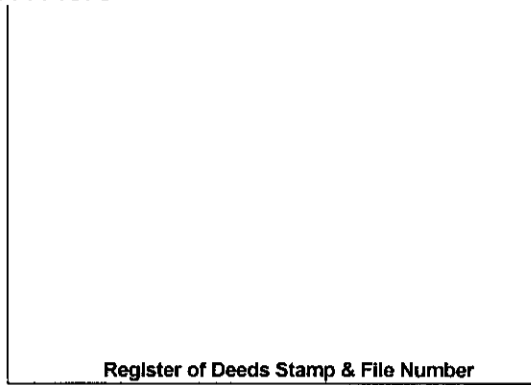

**A. Description of original monument and accessories and/or subsequent restoration:**

- I-5 – GLO – Set Post – J. Mullett – 1846  
Hemlock 12" S36°E 44 L.  
W. Pine 20" N22°W 50 L.
- CSR – FB. # '1A', p. 15 – 1911 – Fd. original wit. W. P. St. 20" N22°W 50 and marked Y. Pine Stp. 20" N78 ¾°E 88.
- S. J. E. Lucas – 1914 Map – This corner located and re-est. by E. G. Monroe in 1898, moved East of this position by G. H. Hollister in 1912. Moved back to the Monroe position by this survey. Set 1 ¼" x 6' Galv. iron pipe.
- MDOT Wit. Card – 1964 – C. F. Roser (L. 1, p. 216 – 1984) – Fd. 1 ¼" pipe – 2' above ground – Marked cedar post  
9" Tw. Maple N70°E 46.78'  
29" Maple (Clp.) S25°W 29.92'  
10" Maple S65°W 22.14'  
29" Tri. Maple N45°W 63.64'

**B. Description of corner evidence found and/or method applied in restoring or re-establishing corner:**

- I-5 – Sec. Cor. common to Sec. 10, 11, 14 & 15 – Fd. 1 ¼" I. D. iron pipe – Up 1.6' – per Lucas & MDOT. 3 of 4 MDOT wits. dead or cut. Also found remains of both of 1911 Wit's, YPS w/ good blaze which makes that position N81° 18' E 10.1'± of Lucas and MDOT position. Lucas and MDOT position is long accepted so 1 ¼" pipe accepted as best available evidence on the position of the original corner.

**C. Description of monument for corner and accessories established to perpetuate locating the position of the corner:**

- I-5 – Set 2" stamped Aluminum cap on 5/8" x 5' long rebar inside found 1 ¼" I.D. iron pipe.  
N45°W 63.12' to set N & T in NE side 32" Maple in clump of 5. (CFR)  
S34°W 18.04' to set N & T in SE side 3" Oak  
N78°E 39.51' to set N & T in NW side 5" White Pine  
S50°E 76.71' to set N & T in NW side 8" White Pine scribed 'XBT'  
Set Blue Carsonite Post 1' North



Signed by: Craig W. McVean Date: 9/22/2005

Surveyor's Michigan License No.: 39088